


Map No. _____ Sec. 31 Twp. 23 R. 10
Well No. 34 - Martindale Farm

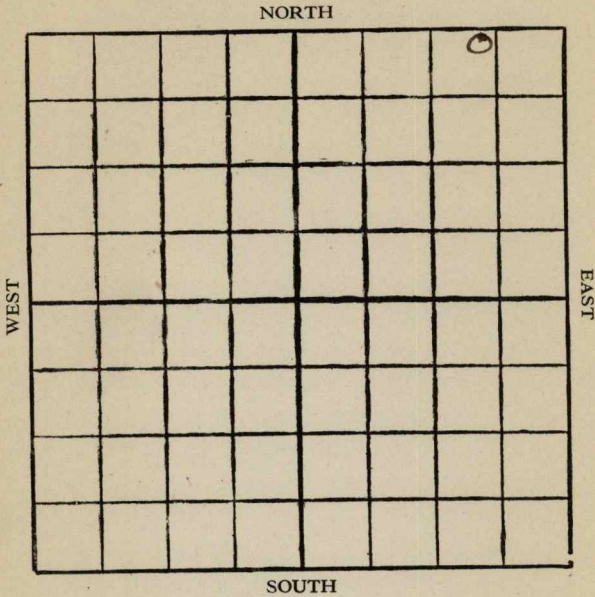

Location _____
Drilling Remarks _____

Rig Up _____
Drilling Remarks _____

RECORD

Cased _____ in. _____ ft.
Sand _____
Gas _____
Oil _____
Total Depth _____

PRODUCTION

1st 24 hrs. Nat. _____
1st 24 hrs. after shot _____
Gas _____ cu. ft.
Dry Hole _____
Abandoned _____


Kansas
 Map No. _____ Sec. 31 Twp. 23 R. 10
 Well No. 34 - Martindale Farm
Mid Kansas Company

264 Ft. from N. Line

_____ Ft. from S. Line

798 Ft. from E. Line

_____ Ft. from W. Line

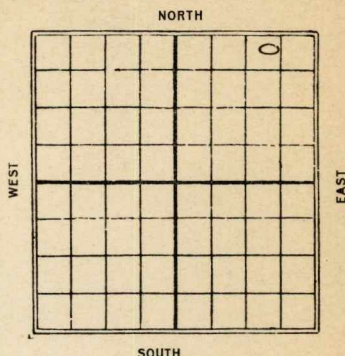

1927

Date

REPORT

<u>2/3</u>	<u>Location</u>
<u>2/10</u>	_____
<u>2/17</u>	_____
<u>2/24</u>	_____
<u>3/2</u>	<u>Rig</u>
<u>3/9</u>	<u>Rigging up</u>
<u>3/16</u>	<u>Spudding</u>
<u>3/24</u>	<u>Drlg 850</u>
<u>3/30</u>	<u>" 1050</u>
<u>4/7</u>	<u>" 1750</u>
<u>4/13</u>	<u>" 2050</u>
<u>4/20</u>	<u>" 2200</u>
<u>4/27</u>	<u>Sand 2315-2322 100 gts</u> <u>40 bbls</u>

Form 26-1M Bks.-3-23-11959. *Sherwood*
16 **KANSAS** *31* *23* *10*
Map No. _____ Sec. _____ Twp. _____ R. _____
Well No. *34 Martindale* _____
Mid-Kansas _____ Company _____
_____ Contractor _____

FIRST REPORTS

SECTION PLAT

264 _____ Ft. from N. Line
_____ Ft. from S. Line
798 _____ Ft. from E. Line
_____ Ft. from W. Line

			<i>0</i>

Location ☒ _____
Rig up _____
Drilling and Remarks: _____

RECORD

Cased _____ in., _____ ft.
Sand _____
Gas _____
Oil _____
Total Depth _____

PRODUCTION

1st 24 hrs. Nat. _____
1st 24 hrs. after shot _____
Gas _____ Cu. Ft.
Dry Hole _____
Abandoned _____

Date **DEC 3 1927** **CHAS. L. SHERWOOD**
_____ *192* _____ Scout

16 **KANSAS** 31 23 10
 Map No. Sec. Twp. R.
 Well No. 34 Martindale
 Mid-Kansas Company

Contractor

COMPLETED**SECTION PLAT**

264 Ft. from N. Line

Ft. from S. Line

798 Ft. from E. Line

Ft. from W. Line

			0

Location

Rig up

Drilling and Remarks:

1007 40 22

RECORD

Cased in., ft.

Sand 2315-2322

Gas

Oil

Total Depth 2322

PRODUCTION

1st 24 hrs. Nat.

1st 24 hrs. after shot

Gas Cu. Ft.

Dry Hole

Abandoned

Date

APR 27 1927

CHAS. L. SHERWOOD

192

Scout