


Kansas

Map No. _____ Sec. 9 Twp. 26 R. 6

Well No. 1 Irwin Farm _____

Henderson & Holden Company

NORTH

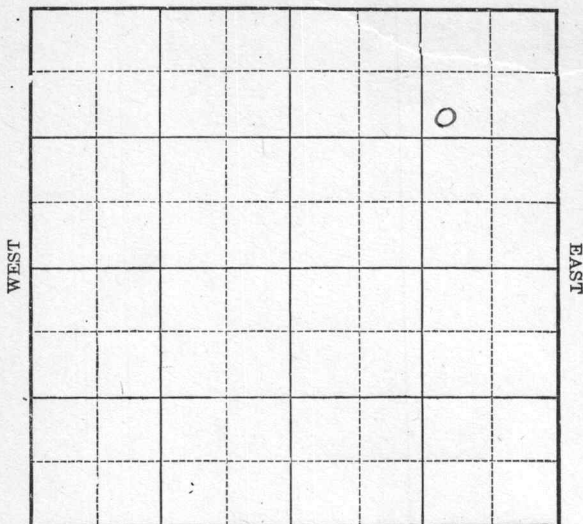

SOUTH

FIRST REPORT

Location _____

Drilling Remarks:

Rig Up _____

Drilling Remarks:

RECORD

Cased _____ in. _____ ft.

Sand _____

Gas _____

Oil _____

Total Depth _____

PRODUCTION

1st 24 hrs. Nat. _____

1st 24 hrs. after shot _____

Gas _____ cu. ft.

Dry Hole _____

Abandoned _____

Map No. _____ Sec. 9 Twp. 26 R. 6


Well No. 1 Town Farm
Henderson & Holden Company

1120 Ft. from N. Line

_____ Ft. from S. Line

1120 Ft. from E. Line

_____ Ft. from W. Line

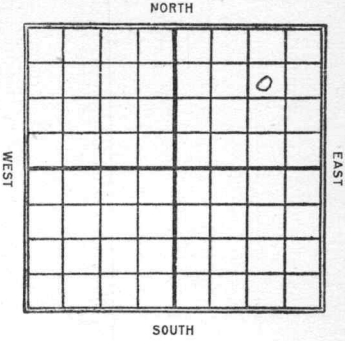

Date
1922

REPORT

10/26 Rig.
1923
1/6 D. & A. 2810'

Map No. **KANSAS** 14 Sec. 9 Twp. 26 R. 6

Well No. 1

Henderson & Halden Company

Contractor

FIRST REPORT

SECTION PLAT

1120 Ft. from N. Line

Ft. from S. Line

1120 Ft. from E. Line

Ft. from W. Line

Location

Rig up

Drilling and Remarks:

RECORD

Cased in., ft.

Sand

Gas

Oil

Total Depth

PRODUCTION

1st 24 hrs. Nat.

1st 24 hrs. after shot

Gas Cu. Ft.

Dry Hole

Abandoned

Date

OCT 26 1922

191

M. A. BENEAR

Scout

Map No. **KANSAS** ¹⁴ Sec. ⁹ Twp. ²⁶ R. ⁶Well No. ¹ *Irwin*
Henderson & Halden Company

Contractor

ABANDONED**SECTION PLAT**^{1120'} Ft. from N. Line

Ft. from S. Line

^{1120'} Ft. from E. Line

Ft. from W. Line

			0

Location

Rig up

Drilling and Remarks:

RECORD

Cased _____ in., _____ ft.

Sand _____

Gas _____

Oil _____

Total Depth _____

PRODUCTION

1st 24 hrs. Nat. _____

1st 24 hrs. after shot _____

Gas _____ Cu. Ft.

Dry Hole _____

Abandoned ²⁸¹⁰ _____

Date

JAN 6 1923

M. A. BENEAR

191 _____

Scout