


Map No. _____ Sec. 30 Twp. 26 R. 5
Well No. 32. Hooper Farm _____
Mag. Pet. Co. Company _____

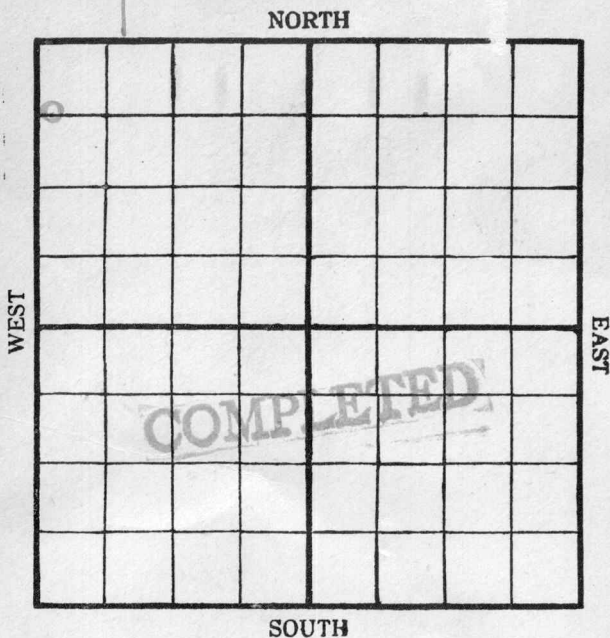

Location _____

Rig Up _____

Drilling Remarks:

Drilling Remarks:

RECORD

PRODUCTION

Cased _____ in. _____ ft.
Sand _____
Gas _____
Oil _____
Total Depth _____

1st 24 hrs. Nat. _____
1st 24 hrs. after shot _____
Gas _____ cu. ft.
Dry Hole _____
Abandoned _____

Map No. 1004 K14 Sec. 30 Twp. 26 R. 5

Well No. 32 Trögler


Magnolia Oil Company

Contractor

NORTH

WEST

EAST

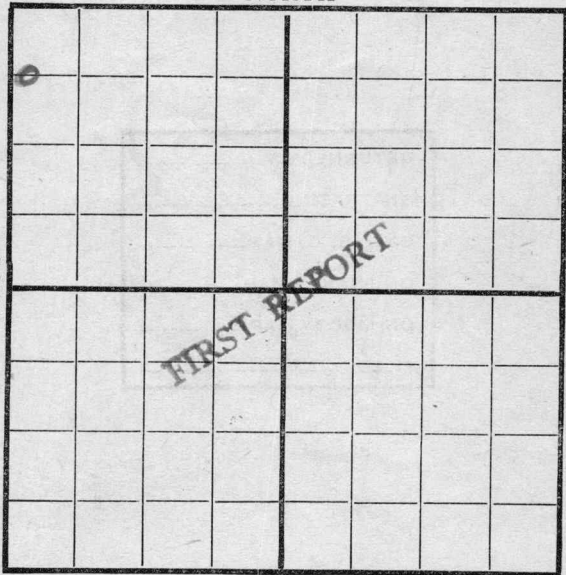

SOUTH

Location _____

Rig up ☒ _____

Drilling and Remarks:

RECORD

Cased _____ in., _____ ft.

Sand _____

Gas _____

Oil _____

Total Depth _____

PRODUCTION

1st 24 hrs. Nat. _____

1st 24 hrs. after shot _____

Gas _____ Cu. Ft.

Dry Hole _____

Abandoned _____

Date

4/5 1918 Tyler Scout


Map No. 104K14 Sec. 30 Twp. 26 R. 5Well No. 32 Koogler
Magnolia Pet- Company

Contractor

NORTH

WEST

EAST

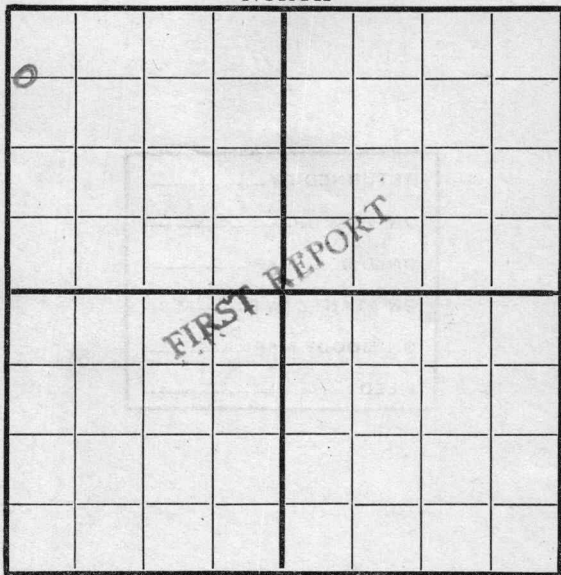

SOUTH

Location _____

Rig up ☒ _____

Drilling and Remarks:

RECORD

Cased _____ in., _____ ft.

Sand _____

Gas _____

Oil _____

Total Depth _____

PRODUCTION

1st 24 hrs. Nat. _____

1st 24 hrs. after shot _____

Gas _____ Cu. Ft.

Dry Hole _____

Abandoned _____

Date

6/11

191

8

Pyle

Scout

Map No. _____ Sec. 30 Twp. 26 R. 5Well No. 32 KnoglerMagnolia _____ Company

_____ Contractor

NORTH

WEST

EAST

SOUTH

Location _____

Rig up _____

Drilling and Remarks:

Spudding

RECORD

Cased _____ in., _____ ft.

Sand _____

Gas _____

Oil _____

Total Depth _____

PRODUCTION

1st 24 hrs. Nat. _____

1st 24 hrs. after shot _____

Gas _____ Cu. Ft.

Dry Hole _____

Abandoned _____

Date

4/9 1918 Cyle Scout

Map No. _____ Sec. 30 Twp. 26 R. 5

Well No. 32 Koogler


Magnolia Company

Contractor _____

NORTH

WEST

EAST

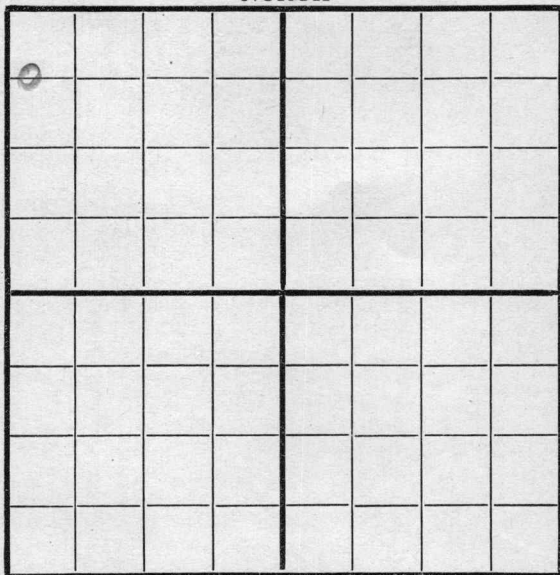

SOUTH

Location _____

Rig up _____

Drilling and Remarks:

RECORD

Cased _____ in., _____ ft.

Sand _____

Gas _____

Oil _____

Total Depth _____

PRODUCTION

1st 24 hrs. Nat. _____

1st 24 hrs. after shot _____

Gas _____ Cu. Ft.


Dry Hole _____

Abandoned _____

Date

6/25 1918 Scout

Map No. _____ Sec. 30 Twp. 26 R. 5
Well No. 32 Royster
Magnolia Company
Charles Cotter & Son Contractor

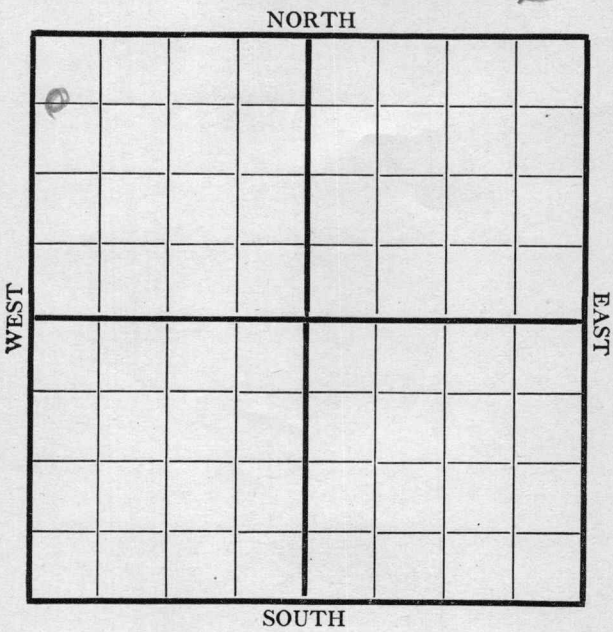

Location _____ Rig up _____ Drilling and Remarks: 930'	RECORD Cased _____ in., _____ ft. Sand _____ Gas _____ Oil _____ Total Depth _____ PRODUCTION 1st 24 hrs. Nat. _____ 1st 24 hrs. after shot _____ Gas _____ Cu. Ft. Dry Hole _____ Abandoned _____
--	--

Date 7/3 1918 Cyle Scout

Map No. _____ Sec. 30 Twp. 26 R. 5


Well No. 32 Hooper Farm

Magnolia Company

NORTH

WEST

EAST

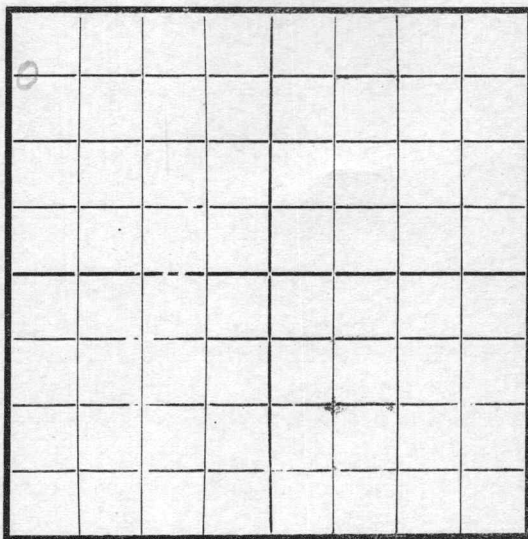

SOUTH

Location _____

Rig Up _____

Drilling and remarks

1545'

RECORD

Cased _____ in. _____ Ft.

Sand _____

Gas _____

Oil _____

Total Depth _____

PRODUCTION

1st 24 hrs. Nat. _____

1st 24 hrs. after shot _____

Gas _____ Cu. Ft.

Dry Hole _____

Abandoned _____

Date

7/10, 1918

C. J. L.

Scout

Map No. _____ Sec. 30 Twp. 26 R. 5

Well No. 39 Keogler

Magnolia _____ Company

_____ Contractor

NORTH

WEST									EAST

SOUTH

Location _____

Rig up _____

Drilling and Remarks:

RECORD

Cased _____ in., _____ ft.

Sand _____

Gas _____

Oil _____

Total Depth _____

PRODUCTION

1st 24 hrs. Nat. _____

1st 24 hrs. after shot _____

Gas _____ Cu. Ft.

Dry Hole _____

Abandoned _____


Date

7/16 1918 Oyle Scout

Map No. _____ Sec. 30 Twp. 26 R. 5Well No. 32 Kogler
Magnolia Company
Contractor _____

NORTH

WEST

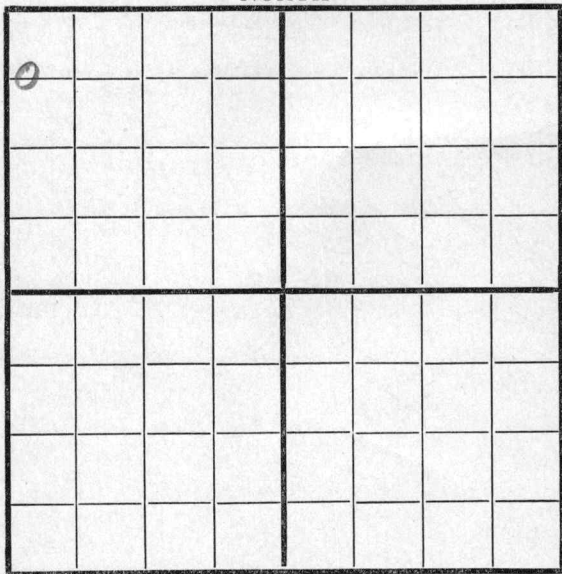

EAST

SOUTH

Location _____

Rig up _____

Drilling and Remarks:

0. 10. 1700

RECORD

Cased _____ in., _____ ft.

Sand _____

Gas _____

Oil _____

Total Depth _____

PRODUCTION

1st 24 hrs. Nat. _____

1st 24 hrs. after shot _____

Gas _____ Cu. Ft.

Dry Hole _____

Abandoned _____

Date

7/24 1918 Oyle Scout

Map No. _____ Sec. 30 Twp. 26 R. 5Well No. 32 RooglerMagnolia _____ Company

_____ Contractor

NORTH

WEST

EAST

SOUTH

Location 660 N250 W

Rig up _____

Drilling and Remarks:

D. 10 @
1700' for
water

RECORD

Cased _____ in., _____ ft.

Sand _____

Gas _____

Oil _____

Total Depth _____

PRODUCTION

1st 24 hrs. Nat. _____

1st 24 hrs. after shot _____

Gas _____ Cu. Ft.

Dry Hole _____

Abandoned _____


Date

7/31 1918 Cyle Scout

Map No. _____ Sec. 30 Twp. 26 R. 5Well No. 32 RooglerMagnolia Company

Contractor _____

NORTH

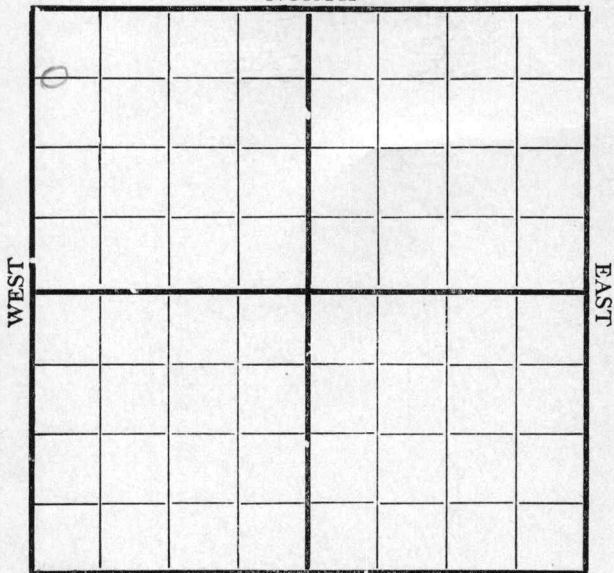

SOUTH

Location 660 N 250 W

Rig up _____

Drilling and Remarks:

RECORD

Cased _____ in., _____ ft.

Sand _____

Gas _____

Oil _____

Total Depth _____

PRODUCTION

1st 24 hrs. Nat. _____

1st 24 hrs. after shot _____

Gas _____ Cu. Ft.

Dry Hole _____

Abandoned _____

Date

8/4 1918 Cyle Scout

Map No. _____ Sec. 30 Twp. 26 R. 5
 Well No. 32 Hoogler
Magnolia Co. Company
 Contractor

NORTH

SOUTH

WEST

EAST

Location 660 N 250 W

Rig up _____

Drilling and Remarks:

D. H 1900'
water

RECORD

Cased _____ in., _____ ft.
 Sand _____
 Gas _____
 Oil _____
 Total Depth _____

PRODUCTION

1st 24 hrs. Nat. _____
 1st 24 hrs. after shot _____
 Gas _____ Cu. Ft.
 Dry Hole _____
 Abandoned _____

Date

8/15 1918 Dyle Scout


Map No. _____ Sec. 30 Twp. 26 R. 5Well No. 32 KrogerMagnolia Pet. Company

Contractor _____

NORTH

WEST

EAST

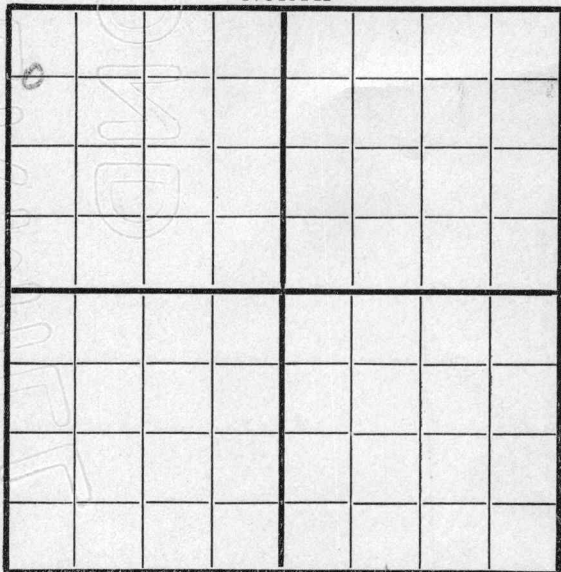

SOUTH

660' N - 250' W

Location _____

Rig up _____

Drilling and Remarks:

2030'

RECORD

Cased _____ in., _____ ft.

Sand _____

Gas _____

Oil _____

Total Depth _____

PRODUCTION

1st 24 hrs. Nat. _____

1st 24 hrs. after shot _____

Gas _____ Cu. Ft.

Dry Hole _____

Abandoned _____

Date

8/221918

Pyle

Scout

Map No. 1514 Sec. 30 Twp. 26 R. 5^EWell No. 32 KooglerMagnolia Oil Company

Contractor

NORTH

WEST

EAST

SOUTH

Location 660 \$ 71
250 \$ 71

Rig up

Drilling and Remarks:

2320'

RECORD

Cased _____ in., _____ ft.

Sand _____

Gas _____

Oil _____

Total Depth _____

PRODUCTION

1st 24 hrs. Nat. _____

1st 24 hrs. after shot _____

Gas _____ Cu. Ft.

Dry Hole _____

Abandoned _____

Date


8/291918

Pyle

Scout

Map No. K14 Sec. 30 Twp. 26 R. 5Well No. 32 Roogler
Magnolia Tex Company

Contractor

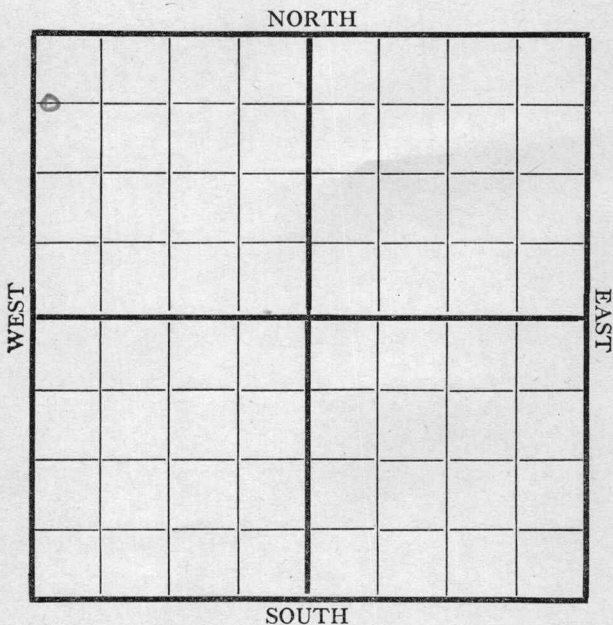

Location <u>660' N</u> <u>250' W</u> Rig up _____ Drilling and Remarks: 2600'	RECORD Cased _____ in., _____ ft. Sand _____ Gas _____ Oil _____ Total Depth _____ PRODUCTION 1st 24 hrs. Nat. _____ 1st 24 hrs. after shot _____ Gas _____ Cu. Ft. Dry Hole _____ Abandoned _____
---	--

Date

9/25

1918

Pyle

Scout

Map No. K14 Sec. 30 Twp. 26 R. 5Well No. 32 Roogler
Magnolia Pub Company

Contractor

NORTH

WEST

EAST

SOUTH

Location 660' N
250' W

Rig up

Drilling and Remarks:

RECORD

Cased _____ in., _____ ft.

Sand _____

Gas _____

Oil _____

Total Depth _____

PRODUCTION

1st 24 hrs. Nat. _____

1st 24 hrs. after shot _____

Gas _____ Cu. Ft.

Dry Hole _____

Abandoned _____

Date

9/18191Pyle

Scout

Map No. K14 Sec. 30 Twp. 26 R. 5Well No. 32 KwoylerMagnolia Company

Contractor

NORTH

WEST

EAST

SOUTH

Location 660 NRig up 250 W

Drilling and Remarks:

D 10 @2320

RECORD

Cased _____ in., _____ ft.

Sand _____

Gas _____

Oil _____

Total Depth _____

PRODUCTION

1st 24 hrs. Nat. _____

1st 24 hrs. after shot _____

Gas _____ Cu. Ft.

Dry Hole _____

Abandoned _____

Date

9/11 1918 Pyle Scout


Map No. K14 Sec. 30 Twp. 26 R. 5Well No. 32 Koopler
Magnolia Pet — Company

Contractor

NORTH

WEST

EAST

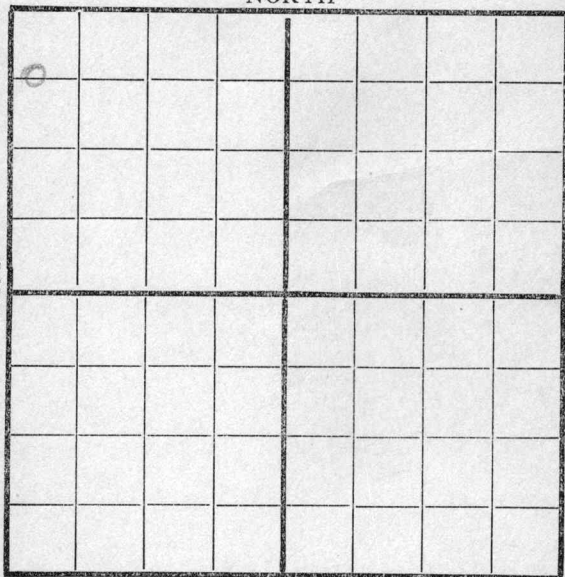

SOUTH

Location _____

Rig up _____

Drilling and Remarks:

250 ~~from~~ W
660 ~~+~~ N

D. N @ 2320'

RECORD

Cased _____ in., _____ ft.

Sand _____

Gas _____

Oil _____

Total Depth _____

PRODUCTION

1st 24 hrs. Nat. _____

1st 24 hrs. after shot _____

Gas _____ Cu. Ft.

Dry Hole _____

Abandoned _____


Date

9/4 1918

Pyle

Scout

Map No. K14 Sec. 30 Twp. 26 R. 5
 Well No. 32 Koogler
Magnolia Oil Company
 Contractor

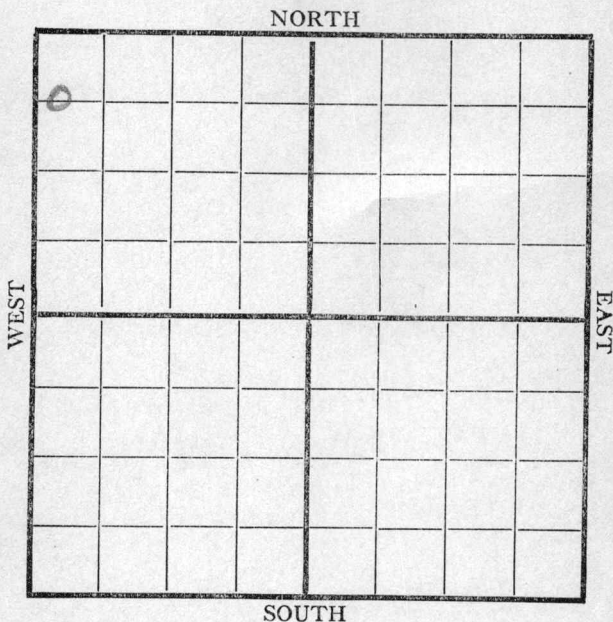

Location 660-N
250-W
 Rig up _____
 Drilling and Remarks:

RECORD

Cased _____ in., _____ ft.
 Sand _____
 Gas _____
 Oil _____
 Total Depth _____

PRODUCTION

1st 24 hrs. Nat. _____
 1st 24 hrs. after shot _____
 Gas _____ Cu. Ft.
 Dry Hole _____
 Abandoned _____

Date

10/2

191

8
Pyle


Scout

Map No. 1514 Sec. 30 Twp. 26 R. 5
 Well No. 32 Kwoqles
Magnolia Out Company
 Contractor

NORTH

WEST

EAST

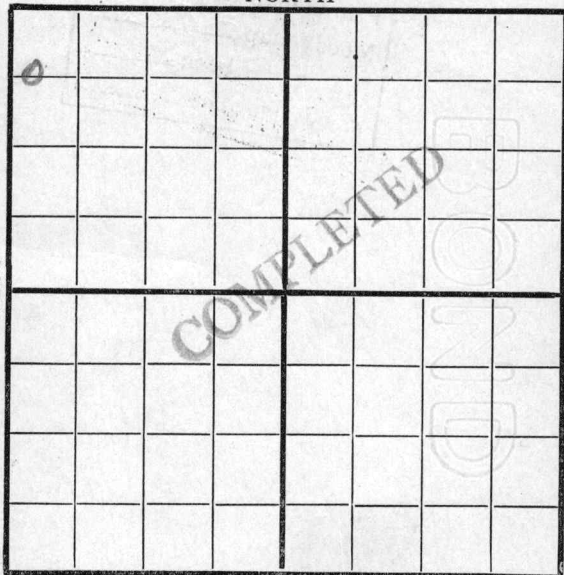

SOUTH

Location 660-NRig up 250-W

Drilling and Remarks:

✓

RECORD

Cased _____ in., _____ ft.

Sand 2652-2670

Gas _____

Oil _____

Total Depth _____

PRODUCTION

1st 24 hrs. Nat. 60 bbls

1st 24 hrs. after shot _____

Gas _____ Cu. Ft.

Dry Hole _____

Abandoned _____

Date

10/8 1918 Oyle Scout