


Map No. _____ Sec. 33 Twp. 26 R. 5Well No. 1-Osborn Farm
Big Walnut Oil Company

NORTH

WEST

EAST

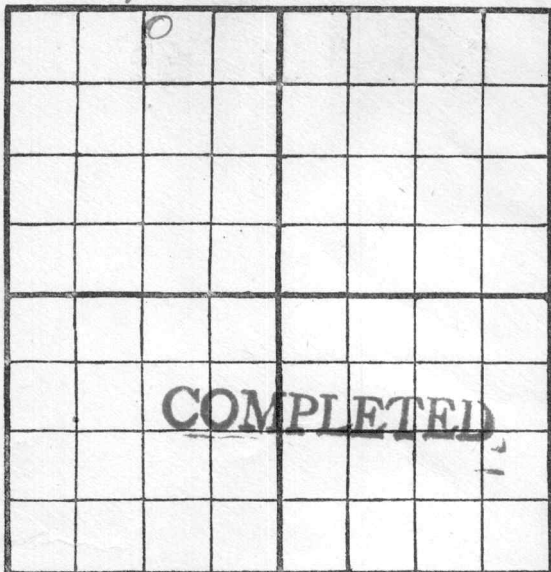

SOUTH

Location _____

Rig Up _____

Drilling Remarks:

Drilling Remarks:

RECORD

Cased _____ in. _____ ft.

Sand _____

Gas _____

Oil _____

Total Depth _____

PRODUCTION

1st 24 hrs. Nat. _____

1st 24 hrs. after shot _____

Gas _____ cu. ft

Dry Hole _____


Abandoned _____

Map No. _____ Sec. 33 Twp. 26 R. 5

Well No. 1 Osborn Farm _____
Big Walnut Oil Company

NORTH

WEST

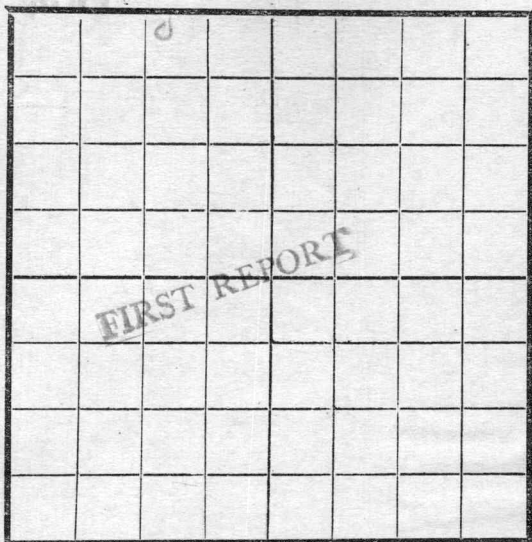

EAST

SOUTH

Location _____

Rig Up ☒ _____

Drilling and remarks _____

RECORD

Cased _____ in. _____ Ft.

Sand _____

Gas _____

Oil _____

Total Depth _____

PRODUCTION

1st 24 hrs. Nat. _____

1st 24 hrs. after shot _____

Gas _____ Cu. Ft.

Dry Hole _____

Abandoned _____

Date


11/7, 1917 Pyle Scout

Map No. _____ Sec. 33 Twp. 26 R. 5
 Well No. 1 Osborn Farm _____
Big Walnut Company _____

NORTH

WEST

EAST

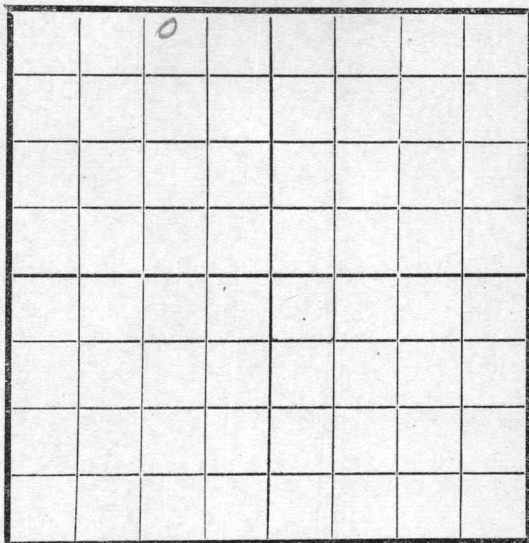

SOUTH

Location _____
 Rig Up _____
 Drilling and remarks _____

1235'

RECORD

Cased _____ in. _____ Ft.
 Sand _____
 Gas _____
 Oil _____
 Total Depth _____

PRODUCTION


1st 24 hrs. Nat. _____
 1st 24 hrs. after shot _____
 Gas _____ Cu. Ft.
 Dry Hole _____
 Abandoned _____

Date 3/11, 1918 Osborn Scout

Map No. _____ Sec. 33 Twp. 26 R. 5
Well No. 1 Osborn Farm _____
Big Walnut Oil Company _____

NORTH

WEST

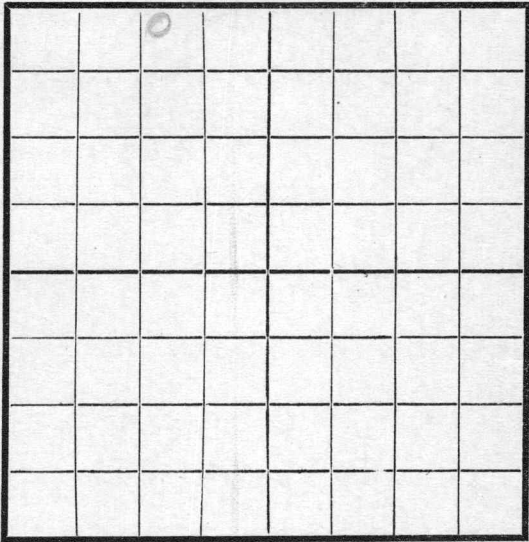

EAST


SOUTH

	RECORD
Location _____	Cased _____ in. _____ Ft.
Rig Up _____	Sand _____
Drilling and remarks	Gas _____
<u>1500'</u>	Oil _____
	Total Depth _____
	PRODUCTION
	1st 24 hrs. Nat. _____
	1st 24 hrs. after shot _____
	Gas _____ Cu. Ft.
	Dry Hole _____
	Abandoned _____

Date 3/18, 1915 Oya Scout _____

Map No. _____ Sec. 33 Twp. 26 R. 5
 Well No. 1 Asborn Farm _____
Big Walnut Company _____

NORTH

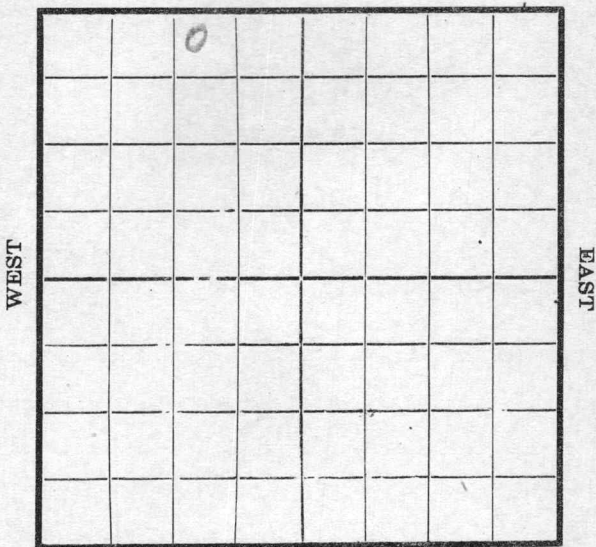

SOUTH

Location _____

Rig Up _____

Drilling and remarks

1700'
Straight
running

RECORD

Cased _____ in. _____ Ft.

Sand _____

Gas _____

Oil _____

Total Depth _____

PRODUCTION

1st 24 hrs. Nat. _____

1st 24 hrs. after shot _____

Gas _____ Cu. Ft.

Dry Hole _____

Abandoned _____

Date

4/10, 1918 975 Scout

Map No. _____ Sec. 33 Twp. 26 R. 5Well No. 1 Osborn Farm _____Big Walnut Oil Company _____

NORTH

WEST

EAST

SOUTH

Location _____

Rig Up _____

Drilling and remarks

RECORD .
Cased _____ in _____ Ft.

Sand _____

Gas _____

Oil _____

Total Depth _____

PRODUCTION

1st 24 hrs. Nat. _____

1st 24 hrs. after shot _____

Gas _____ Cu. Ft.

Dry Hole _____

Abandoned _____


Date

3/25, 1918 D. J. L. Scout

Map No. _____ Sec. 33 Twp. 26 R. 5Well No. 1 Osborn Farm _____Company Big Walnut

NORTH

WEST

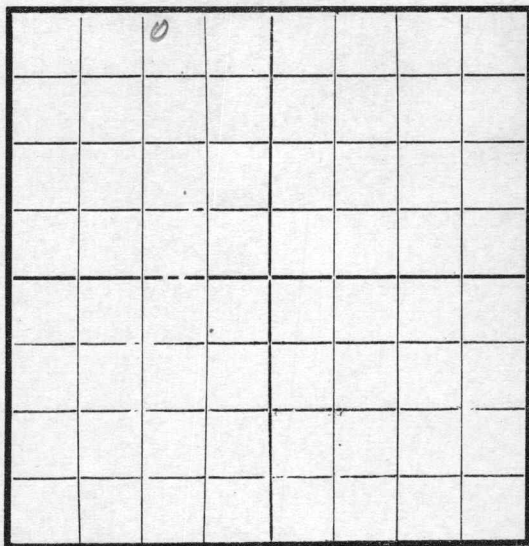

EAST

SOUTH

Location _____

Rig Up _____

Drilling and remarks

H. R. 10"
@ 1645

RECORD

Cased _____ in. _____ Ft.

Sand _____

Gas _____

Oil _____

Total Depth _____

PRODUCTION

1st 24 hrs. Nat. _____

1st 24 hrs. after shot _____

Gas _____ Cu. Ft.

Dry Hole _____

Abandoned _____


Date

_____, 1918 _____ Scout

Map No. _____ Sec. 33 Twp. 26 R. 5Well No. 1 Osborn Farm _____
Big Walnut Oil Company

NORTH

WEST

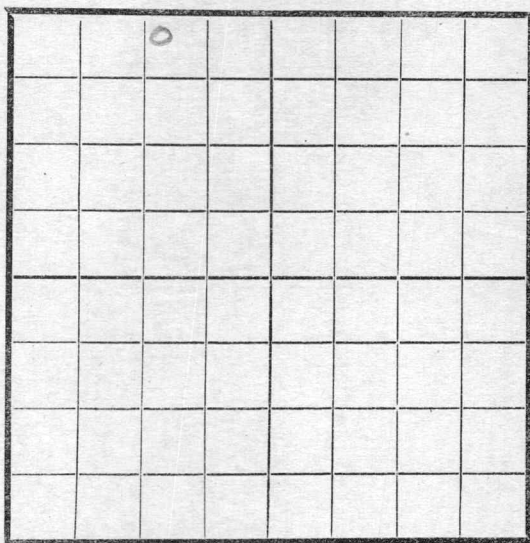

EAST

SOUTH

Location _____

Rig Up _____

Drilling and remarks

M. R. 10"
To 1700'

RECORD

Cased _____ in. _____ Ft.

Sand _____

Gas _____

Oil _____

Total Depth _____

PRODUCTION

1st 24 hrs. Nat. _____

1st 24 hrs. after shot _____

Gas _____ Cu. Ft.

Dry Hole _____

Abandoned _____


Date

4/8, 191*8* *Lyn* Scout
23

Map No. _____ Sec. 33 Twp. 26 R. 5

Well No. 1 Osborn Farm _____
Big Walnut Oil Company

NORTH

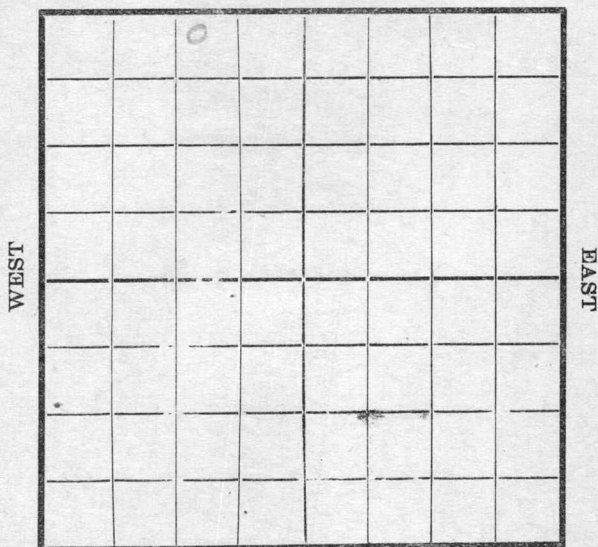

SOUTH

Location _____

Rig Up _____

Drilling and remarks

1900'

RECORD

Cased _____ in. _____ Ft.

Sand _____

Gas _____

Oil _____

Total Depth _____

PRODUCTION

1st 24 hrs. Nat. _____

1st 24 hrs. after shot _____

Gas _____ Cu. Ft.

Dry Hole _____

Abandoned _____


Date

5/8, 1918 C. J. K. Scout

Map No. _____ Sec. 33 Twp. 26 R. 5
 Well No. 1 Asbarn Farm _____
Big Walnut Oil Company

NORTH

WEST

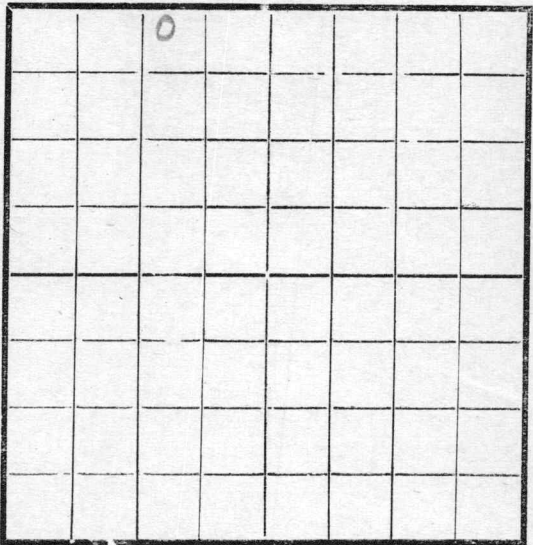

EAST

SOUTH

Location _____
 Rig Up _____
 Drilling and remarks

2190'

RECORD

Cased _____ in. _____ Ft.
 Sand _____
 Gas _____
 Oil _____
 Total Depth _____

PRODUCTION

1st 24 hrs. Nat. _____
 1st 24 hrs. after shot _____
 Gas _____ Cu. Ft.
 Dry Hole _____
 Abandoned _____


Date

5/8, 1918 Tyler Scout

Map No. _____ Sec. 33 Twp. 26 R. 5Well No. 1 Osborn Farm _____Big Walnut Oil Company

NORTH

WEST

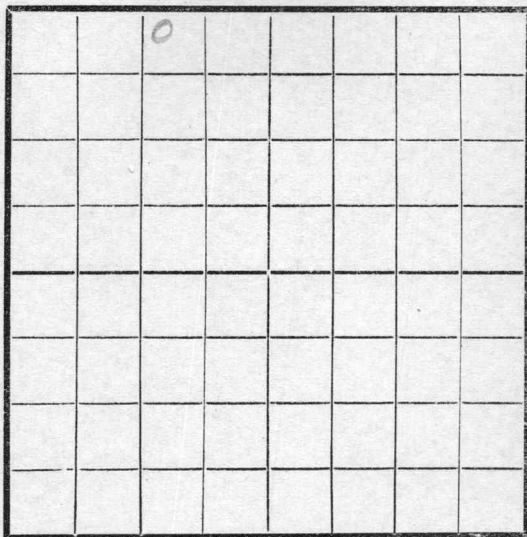

EAST

SOUTH

Location _____

Rig Up _____

Drilling and remarks

2190' A.O.for casing

RECORD

Cased _____ in. _____ Ft.

Sand _____

Gas _____

Oil _____

Total Depth _____

PRODUCTION

1st 24 hrs. Nat. _____

1st 24 hrs. after shot _____

Gas _____ Cu. Ft.

Dry Hole _____

Abandoned _____


Date

5/8, 191813J. L. Scout

Map No. _____ Sec. 33 Twp. 24 R. 5Well No. 1 Osborn Farm _____
Big Walnut Oil Company

NORTH

WEST

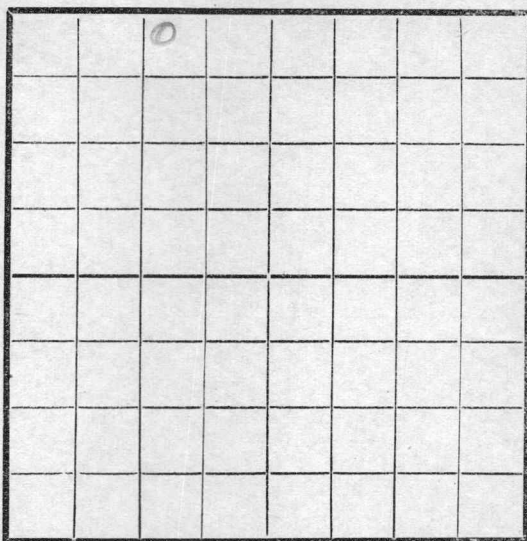

EAST

SOUTH

Location _____

Rig Up _____

Drilling and remarks

Ø, 10.2275

RECORD

Cased _____ in. _____ Ft.

Sand _____

Gas _____

Oil _____

Total Depth _____

PRODUCTION

1st 24 hrs. Nat. _____

1st 24 hrs. after shot _____

Gas _____ Cu. Ft.

Dry Hole _____

Abandoned _____

Date

5/13, 1918

Scout

Map No. _____ Sec. 33 Twp. 26 R. 5Well No. 1 AslawnBig Walnut Oil Company

Contractor _____

NORTH

WEST

EAST

SOUTH

Location _____

Rig up _____

Drilling and Remarks:

D.O. for casing,
2190'

RECORD

Cased _____ in., _____ ft.

Sand _____

Gas _____

Oil _____

Total Depth _____

PRODUCTION

1st 24 hrs. Nat. _____

1st 24 hrs. after shot _____

Gas _____ Cu. Ft.

Dry Hole _____

Abandoned _____

Date

5/8 *Cyle* Scout
128 191

Map No. 33 Sec. 33 Twp. 26 R. 5
Well No. 1
Contractor _____

NORTH				SOUTH			

EAST

WEST

Location _____	Drilling and Remarks: <u>2300'</u> <u>2.10 @</u>
Rig up _____	
Cased _____ in, _____ ft.	
Sand _____	
Gas _____	
Oil _____	
Total Depth _____	
RECORD	
PRODUCTION	
1st 24 hrs. Nat. _____	
1st 24 hrs. after shot _____	
Gas _____ Cu. Ft. _____	
Dry Hole _____	
Abandoned _____	

Date 4/19 1918
Day
Scout

Map No. _____ Sec. 33 Twp. 26 R. 5

Well No. _____

Big Walnut Oil Company

Contractor _____

NORTH

WEST

EAST

SOUTH

Location _____

Rig up _____

Drilling and Remarks:

RECORD

Cased _____ in., _____ ft.

Sand _____

Gas _____

Oil _____

Total Depth _____

PRODUCTION

1st 24 hrs. Nat. _____

1st 24 hrs. after shot _____

Gas _____ Cu. Ft.

Dry Hole _____

Abandoned _____

Date

6/25 1918Scout

Map No. _____ Sec. 33 Twp. 26 R. 5
 Well No. 1 Osborn
Big Walnut Oil Company _____
 Contractor _____

NORTH							
WEST			0				
SOUTH							
EAST							

Location _____ Rig up _____ Drilling and Remarks: 2440'	RECORD Cased _____ in., _____ ft. Sand _____ Gas _____ Oil _____ Total Depth _____ PRODUCTION 1st 24 hrs. Nat. _____ 1st 24 hrs. after shot _____ Gas _____ Cu. Ft. Dry Hole _____ Abandoned _____
---	---

Date 7/3 1918 Osborn Scout

Map No. _____ Sec. 33 Twp. 26 R. 5Well No. 1 OsbornBig Walnut Company

Contractor _____

NORTH

WEST

EAST

SOUTH

Location _____

Rig up _____

Drilling and Remarks:

2630

RECORD

Cased _____ in., _____ ft.

Sand _____

Gas _____

Oil _____

Total Depth _____

PRODUCTION

1st 24 hrs. Nat. _____

1st 24 hrs. after shot _____

Gas _____ Cu. Ft.

Dry Hole _____

Abandoned _____


Date

7/8 191817Cyle Scout

Map No. _____ Sec. 33 Twp. 26 R. 5Well No. 1 OsbornBig Walnut Oil Company

Contractor _____

NORTH

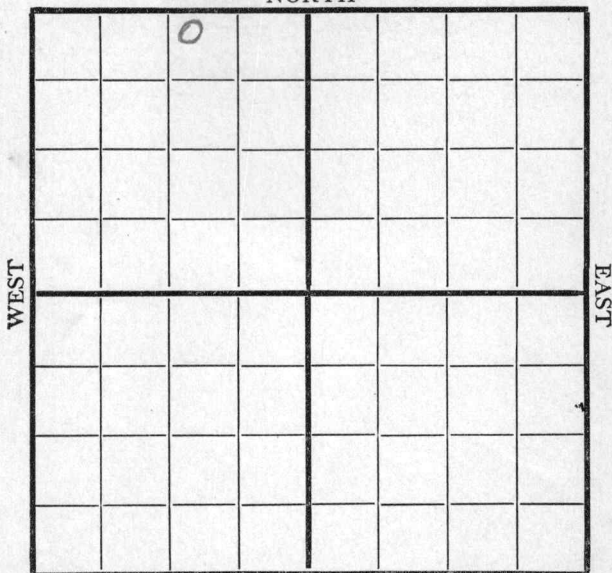

SOUTH

Location _____

Rig up _____

Drilling and Remarks:

RECORD

Cased _____ in., _____ ft.

Sand _____

Gas _____

Oil _____

Total Depth _____

PRODUCTION

1st 24 hrs. Nat. _____

1st 24 hrs. after shot _____

Gas _____ Cu. Ft.

Dry Hole _____

Abandoned _____

Date

7/26 1918 Osborn Scout

Map No. _____ Sec. 33 Twp. 26 R. 5

Well No. 1 Asborn


Big Walnut Oil Company

Contractor _____

NORTH

WEST

EAST

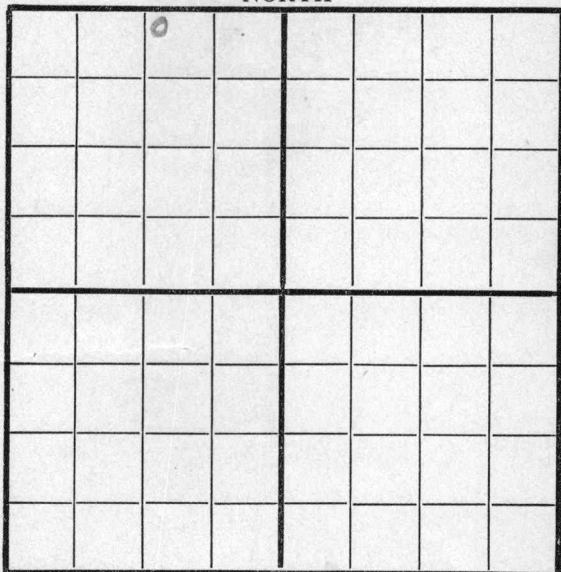

SOUTH

300 N

Location 1070 E

Rig up _____

Drilling and Remarks:

D. 10 @

2680

RECORD

Cased _____ in., _____ ft.

Sand _____

Gas _____

Oil _____

Total Depth _____

PRODUCTION

1st 24 hrs. Nat. _____

1st 24 hrs. after shot _____

Gas _____ Cu. Ft.

Dry Hole _____

Abandoned _____

Date

8/2

191

8

C. y. h. S

Map No. _____ Sec. 33 Twp. 26 R. 5
 Well No. 1 Osborn
Big Walnut Oil Company
 _____ Contractor

NORTH							
WEST							
SOUTH							

Location _____

Rig up _____

Drilling and Remarks:

S. D. @
2190

RECORD

Cased _____ in., _____ ft.
 Sand _____
 Gas _____
 Oil _____
 Total Depth _____


PRODUCTION

1st 24 hrs. Nat. _____
 1st 24 hrs. after shot _____
 Gas _____ Cu. Ft.
 Dry Hole _____
 Abandoned _____

Date

4/3 1918 Cyle Scout

Map No. _____ Sec. 33 Twp. 26 R. 5
Well No. 1 Osborn
Big Walnut Oil Company _____
Contractor _____

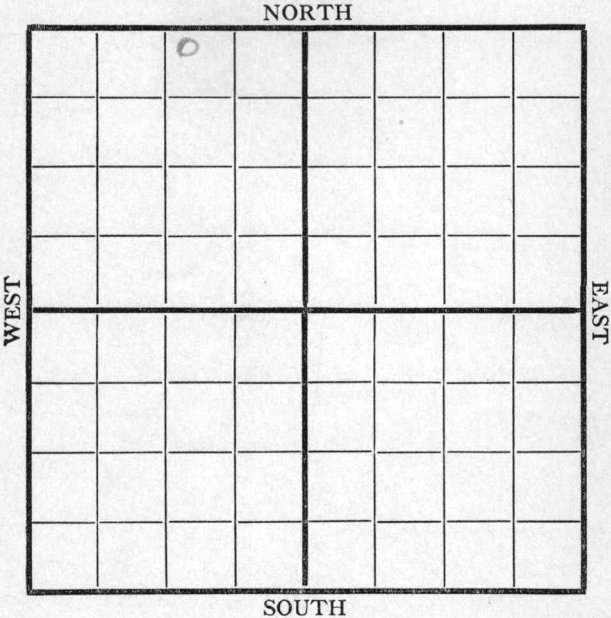

Location 300' A
1020' E

Rig up _____

Drilling and Remarks:
fishing
casing
2630'

RECORD

Cased _____ in., _____ ft.
Sand _____
Gas _____
Oil _____
Total Depth _____

PRODUCTION


1st 24 hrs. Nat. _____
1st 24 hrs. after shot _____
Gas _____ Cu. Ft.
Dry Hole _____
Abandoned _____

Date 8/2 1918 Dyer Scout

Map No. _____ Sec. 33 Twp. 26 R. 5Well No. 1 Osborn Farm _____Big Walnut Oil Company _____

NORTH

WEST

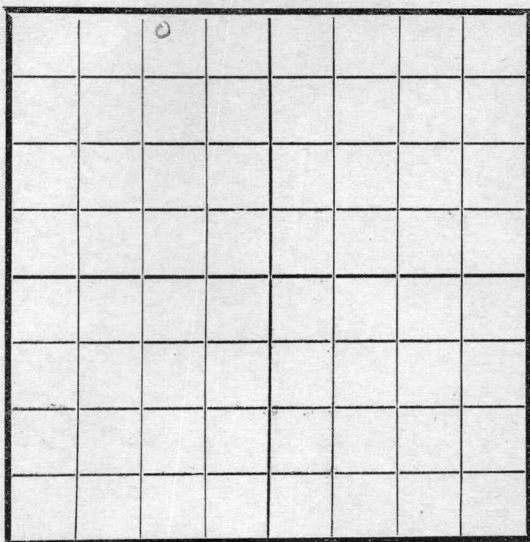

EAST

SOUTH

Location _____

Rig Up ☒ _____

Drilling and remarks _____

RECORD

Cased _____ in. _____ Ft.

Sand _____

Gas _____

Oil _____

Total Depth _____

PRODUCTION

1st 24 hrs. Nat. _____

1st 24 hrs. after shot _____

Gas _____ Cu. Ft.

Dry Hole _____


Abandoned _____

Date

11/14, 1917 Pyle Scout

Map No. _____ Sec. 33 Twp. 26 R. 5
 Well No. 1 Asborn Farm _____

NORTH

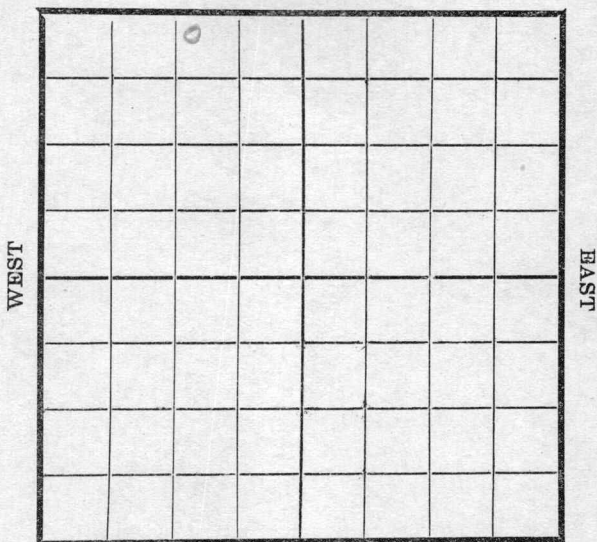

SOUTH

Location _____
 Rig Up ☒ _____
 Drilling and remarks _____

RECORD

Cased _____ in. _____ Ft.
 Sand _____
 Gas _____
 Oil _____
 Total Depth _____

PRODUCTION

1st 24 hrs. Nat. _____
 1st 24 hrs. after shot _____
 Gas _____ Cu. Ft.
 Dry Hole _____
 Abandoned _____


Date

11/21, 1917 Pyle Scout

Map No. _____ Sec. 33 Twp. 26 R. 5
 Well No. 1 Asborn Farm _____
Big Walnut Company _____

NORTH

WEST

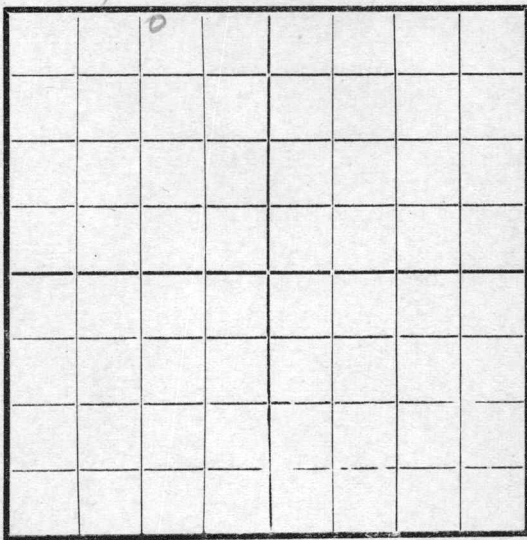

EAST

SOUTH

Location _____

Rig Up ☒ _____

Drilling and remarks _____

RECORD

Cased _____ in. _____ Ft.

Sand _____

Gas _____

Oil _____

Total Depth _____

PRODUCTION

1st 24 hrs. Nat. _____

1st 24 hrs. after shot _____

Gas _____ Cu. Ft.

Dry Hole _____


Abandoned _____

Date

11/28, 1917 Lytle Scout

Map No. _____ Sec. 33 Twp. 26 R. 5Well No. 1 Asborn Farm
Big Walnut Company

NORTH

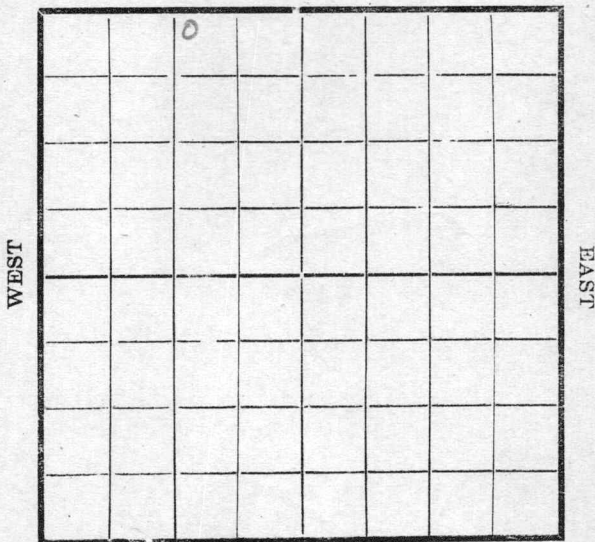

SOUTH

Location _____

Rig Up ☒ _____

Drilling and remarks _____

RECORD

Cased _____ in. _____ Ft.

Sand _____

Gas _____

Oil _____

Total Depth _____

PRODUCTION

1st 24 hrs. Nat. _____

1st 24 hrs. after shot _____

Gas _____ Cu. Ft.

Dry Hole _____

Abandoned _____


Date

12/8, 1917 Pyle Scout

Map No. _____ Sec. 33 Twp. 26 R. 5Well No. 1 Asborn Farm _____Big Walnut Company _____

NORTH

WEST

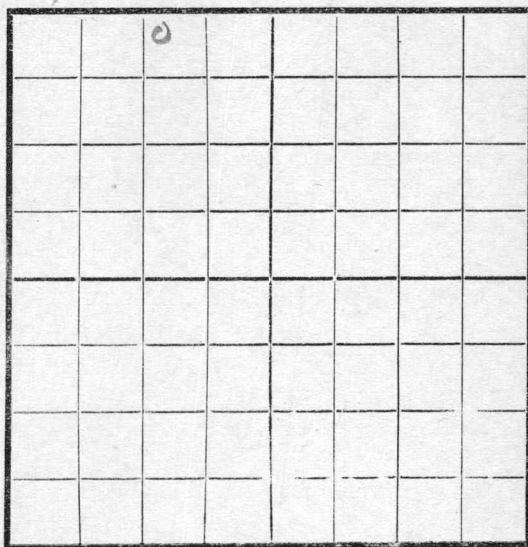

EAST

SOUTH

Location _____

Rig Up _____

Drilling and remarks

Spud

RECORD

Cased _____ in. _____ Ft.

Sand _____

Gas _____

Oil _____

Total Depth _____

PRODUCTION

1st 24 hrs. Nat. _____

1st 24 hrs. after shot _____

Gas _____ Cu. Ft.

Dry Hole _____

Abandoned _____

Date


12/27, 1917*Oyle*

Scout

Map No. _____ Sec. 33 Twp. 26 R. 5Well No. 1 Ashborn Farm _____Big Walnut Company _____

NORTH

WEST

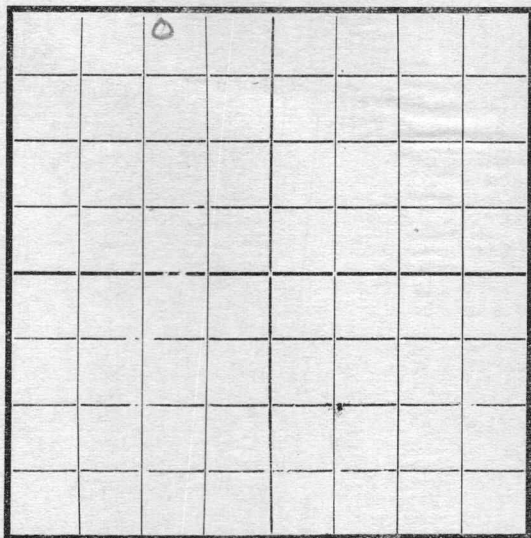

SOUTH

Location _____

Rig Up _____

Drilling and remarks

RECORD

Cased _____ in. _____ Ft.

Sand _____

Gas _____

Oil _____

Total Depth _____

PRODUCTION

1st 24 hrs. Nat. _____

1st 24 hrs. after shot _____

Gas _____ Cu. Ft.

Dry Hole _____


Abandoned _____

Date

1/2, 1918 Oyle Scout

Map No. _____ Sec. 33 Twp. 24 R. 5
 Well No. 1 Osborn Farm _____
Big Walnut Company _____

NORTH

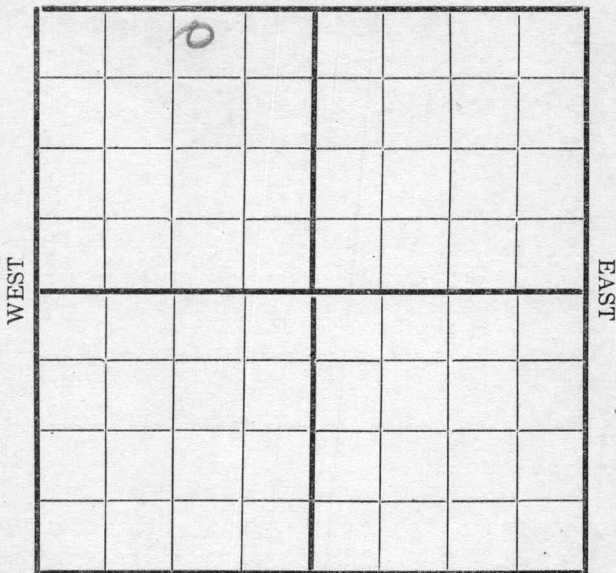

SOUTH

Location _____
 Rig Up _____
 Drilling and remarks _____

RECORD

Cased _____ in. _____ Ft.
 Sand _____
 Gas _____
 Oil _____
 Total Depth _____

PRODUCTION

1st 24 hrs. Nat. _____
 1st 24 hrs. after shot _____
 Gas _____ Cu. Ft.
 Dry Hole _____
 Abandoned _____


Date

1/9, 1918 Oyle Scout

Map No. _____ Sec. 33 Twp. 26 R. 5

Well No. 1 Osborn Farm _____
Big Walnut Company _____

NORTH

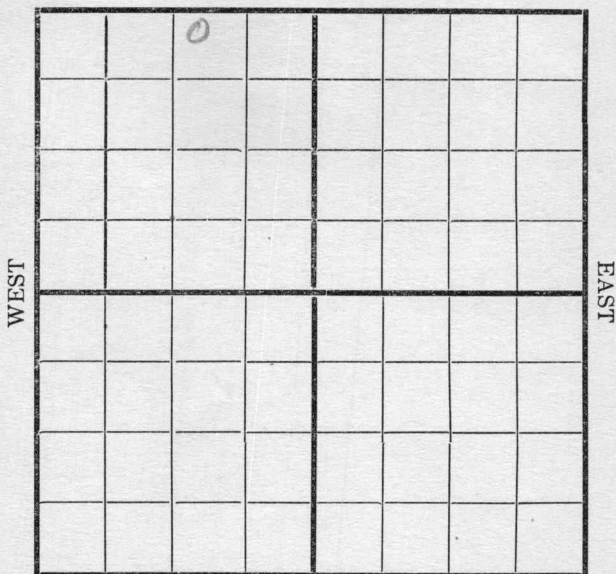

SOUTH

Location _____
 Rig Up _____
 Drilling and remarks _____

2 @ 300'

RECORD

Cased _____ in. _____ Ft.
 Sand _____
 Gas _____
 Oil _____
 Total Depth _____

PRODUCTION


1st 24 hrs. Nat. _____
 1st 24 hrs. after shot _____
 Gas _____ Cu. Ft.
 Dry Hole _____
 Abandoned _____

Date 1/5 1918 Pyke Scout

Map No. _____ Sec. 33 Twp. 26 R. 5
Well No. 1 Osborn Farm _____
Big Walnut Company _____

NORTH

WEST

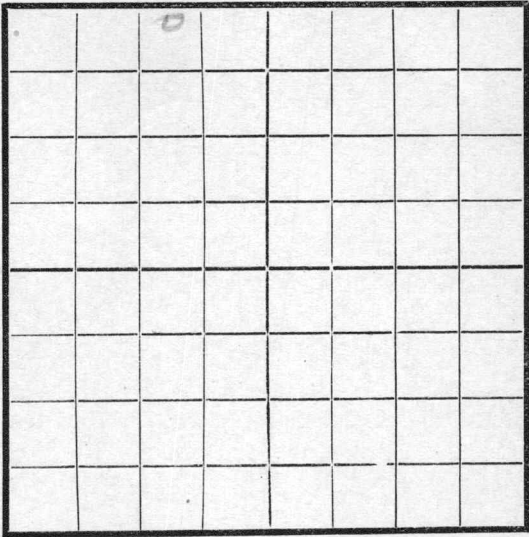

EAST

SOUTH

Location _____
Rig Up _____
Drilling and remarks _____

RECORD

Cased _____ in. _____ Ft.
Sand _____
Gas _____
Oil _____
Total Depth _____

PRODUCTION


1st 24 hrs. Nat. _____
1st 24 hrs. after shot _____
Gas _____ Cu. Ft.
Dry Hole _____
Abandoned _____

Date _____, 1918 8 July Scout
30

Map No. _____ Sec. 33 Twp. 26 R. 5Well No. 1 Osborn Farm _____Big Walnut Oil Company _____

NORTH

WEST

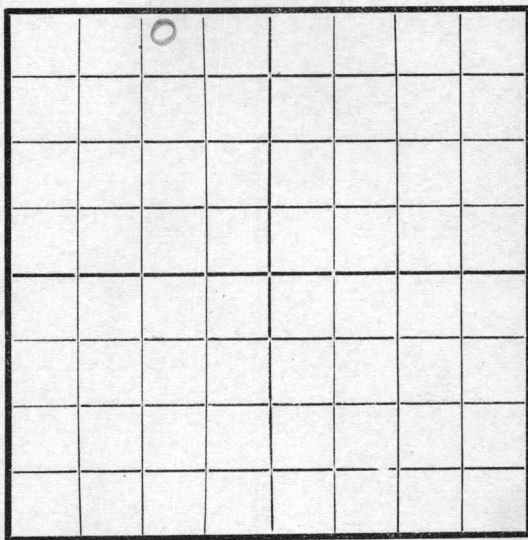

EAST

SOUTH

Location _____

Rig Up _____

Drilling and remarks

400'

RECORD

Cased _____ in. _____ Ft.

Sand _____

Gas _____

Oil _____

Total Depth _____

PRODUCTION

1st 24 hrs. Nat. _____

1st 24 hrs. after shot _____

Gas _____ Cu. Ft.

Dry Hole _____

Abandoned _____


Date

2/12, 1918 Pyle Scout

Map No. _____ Sec. 33 Twp. 24 R. 5
 Well No. 1 Osborn Farm _____
Big Walnut Company _____

NORTH

WEST

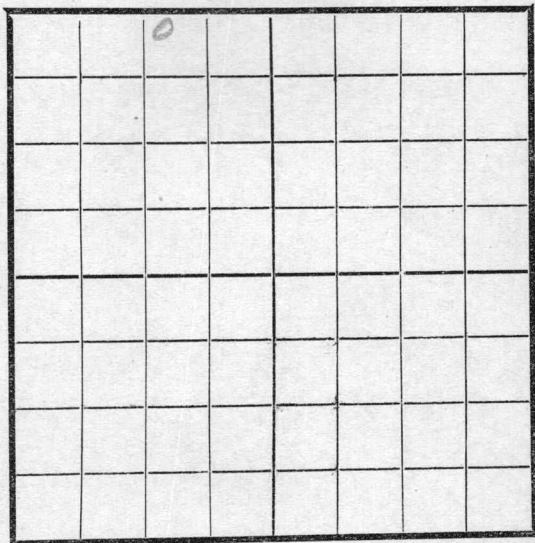

EAST

SOUTH

Location _____
 Rig Up _____
 Drilling and remarks

600'

RECORD

Cased _____ in. _____ Ft.
 Sand _____
 Gas _____
 Oil _____
 Total Depth _____

PRODUCTION


1st 24 hrs. Nat. _____
 1st 24 hrs. after shot _____
 Gas _____ Cu. Ft.
 Dry Hole _____
 Abandoned _____

Date

7/20, 1918 Wyle Scout

Map No. _____ Sec. 33 Twp. 26 R. 5
Well No. 1 Osborn Farm _____
Big Walnut Company _____

NORTH

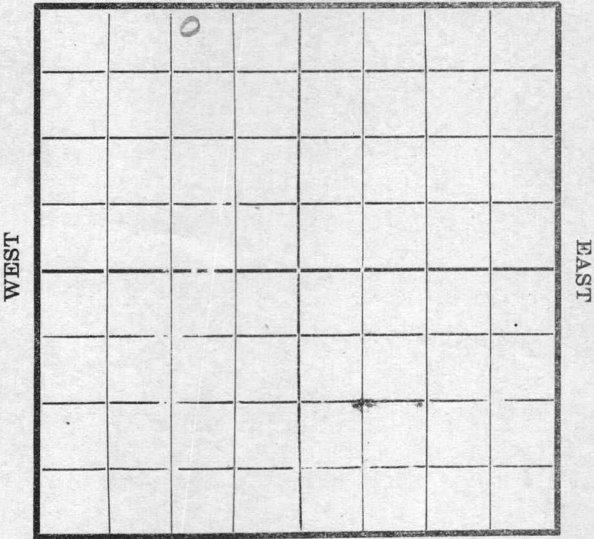

SOUTH

RECORD

Location _____
Rig Up _____
Drilling and remarks

Cased _____ in. _____ Ft.
Sand _____
Gas _____
Oil _____
Total Depth _____


PRODUCTION

1st 24 hrs. Nat. _____
1st 24 hrs. after shot _____
Gas _____ Cu. Ft.
Dry Hole _____
Abandoned _____

Date

7/8, 1918 Pyle Scout
27

Map No. _____ Sec. 33 Twp. 24 R. 5
 Well No. 1 Ashburn Farm _____
Big Walnut Company _____

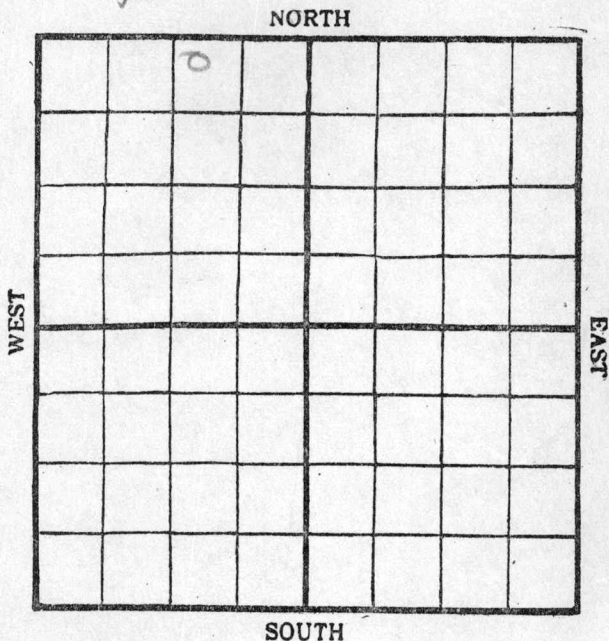

Location _____

Rig Up _____

Drilling and remarks

RECORD

Cased _____ in. _____ Ft.

Sand _____

Gas _____

Oil _____

Total Depth _____

PRODUCTION

1st 24 hrs. Nat. _____

1st 24 hrs. after shot _____

Gas _____ Cu. Ft.

Dry Hole _____

Abandoned _____

Date

2/4, 1918, J. L. Scout Scout


Map No. _____ Sec. 33 Twp. 26 R. 5

Well No. 1 Osborn Farm _____

Big Walnut Oil Company _____

NORTH

WEST

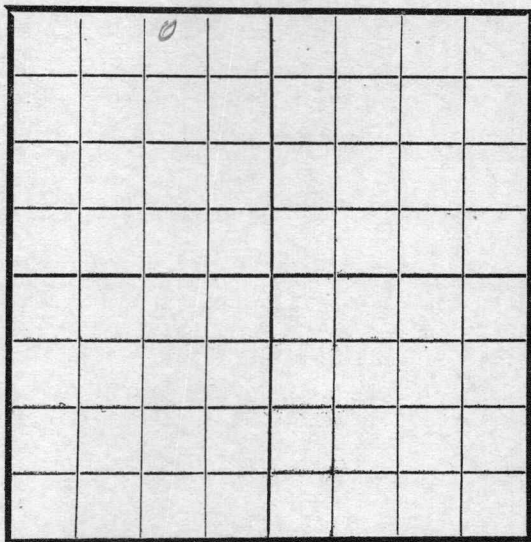

EAST

SOUTH

RECORD

Location _____

Cased _____ in. _____ Ft.

Rig Up _____

Sand _____

Drilling and remarks

Gas _____

Oil _____

Total Depth _____

PRODUCTION

1st 24 hrs. Nat. _____

1st 24 hrs. after shot _____

Gas _____ Cu. Ft.

Dry Hole _____

Abandoned _____

Date


191

Scout

Map No. _____ Sec. 33 Twp. 26 R. 5
 Well No. 1 Osborn Farm _____
Big Walnut Oil Company

NORTH

WEST

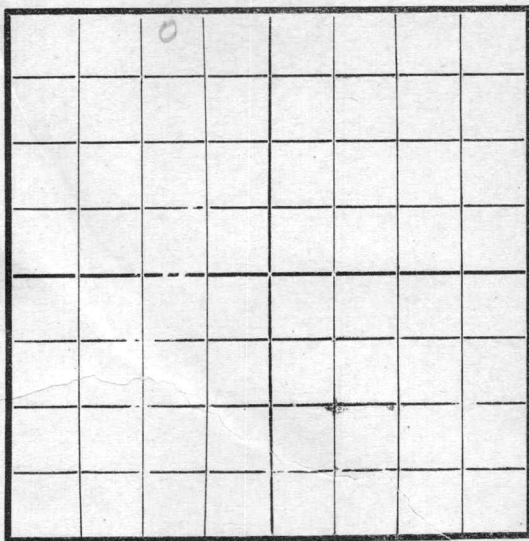

EAST

SOUTH

Location _____
 Rig Up _____
 Drilling and remarks

2500'

RECORD

Cased _____ in. _____ Ft.
 Sand _____
 Gas _____
 Oil _____
 Total Depth _____

PRODUCTION

1st 24 hrs. Nat. _____
 1st 24 hrs. after shot _____
 Gas _____ Cu. Ft.
 Dry Hole _____
 Abandoned _____

Date

7/10, 1918 Pyle Scout

Map No. _____ Sec. 33 Twp. 26 R. 5

Well No. 1 Osborn


Big Walnut Oil Company

Contractor _____

NORTH

WEST

EAST

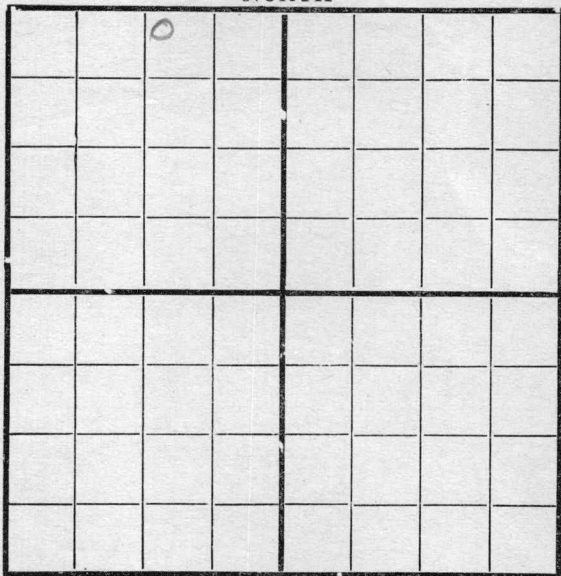

SOUTH

300 N
Location 1020 E

Rig up _____

Drilling and Remarks:

2680'

RECORD

Cased _____ in., _____ ft.

Sand _____

Gas _____

Oil _____

Total Depth _____

PRODUCTION

1st 24 hrs. Nat. _____

1st 24 hrs. after shot _____

Gas _____ Cu. Ft.

Dry Hole _____

Abandoned _____

Date

7/6

191

8

Oyle

Scout

Map No. _____ Sec. 33 Twp. 26 R. 5

Well No. 1

Big Walnut Oil Company

Contractor _____

NORTH

WEST

EAST

SOUTH

300 N-1070 E

Location _____

Rig up _____

Drilling and Remarks:

RECORD

Cased _____ in., _____ ft.

Sand _____

Gas _____

Oil _____

Total Depth _____

PRODUCTION

1st 24 hrs. Nat. _____

1st 24 hrs. after shot _____

Gas _____ Cu. Ft.

Dry Hole _____

Abandoned _____

2706

Date

8/22 1918

Pvle

Scout

1004 K14 Map No. Sec. 33 Twp. 26 R. 5


Well No. 1 Osborn
Big Walnut Oil Company

Contractor

NORTH

WEST

EAST

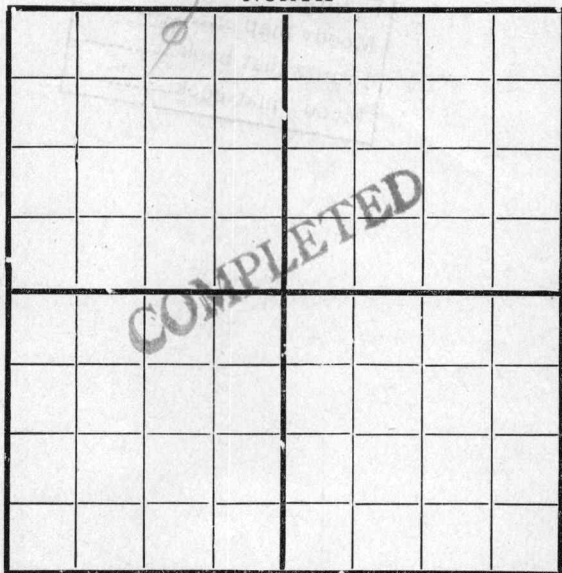

SOUTH

3007
Location 1020 E

Rig up

Drilling and Remarks:

RECORD

Cased _____ in., _____ ft.

Sand _____

Gas _____

Oil _____

Total Depth _____

PRODUCTION

1st 24 hrs. Nat. _____

1st 24 hrs. after shot _____

Gas _____ Cu. Ft.

Dry Hole 2769

Abandoned _____

Date

191

8

Oyle


Scout

8/28

Map No. _____ Sec. 33 Twp. 26 R. 5Well No. 1 Osborn Farm _____Big Walnut Company _____

NORTH

WEST

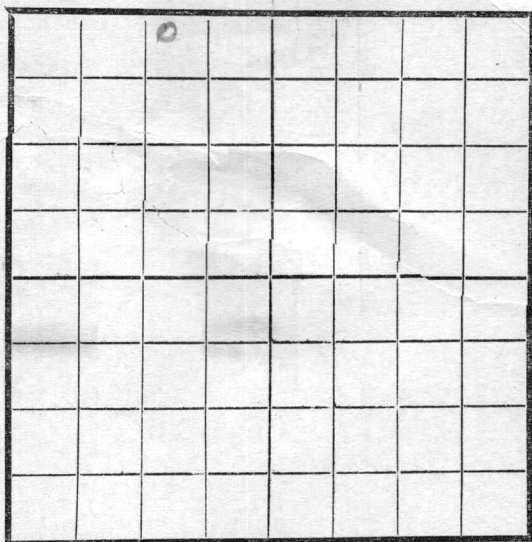

EAST

SOUTH

RECORD

Location _____

Cased _____ in. _____ Ft.

Rig Up _____

Sand _____

Drilling and remarks

Gas _____

Oil _____

Total Depth _____

PRODUCTION

1st 24 hrs. Nat. _____

1st 24 hrs. after shot _____

Gas _____ Cu. Ft.

Dry Hole _____

Abandoned _____

Date

3/5, 1918

Scout