

KANSAS


Greenwood

FORM 51 5M 4-41 PETROL

Section 15 Township 23 Range 13E

Well No. #22 Shadel

Company O. K. O. Oil & Gas.

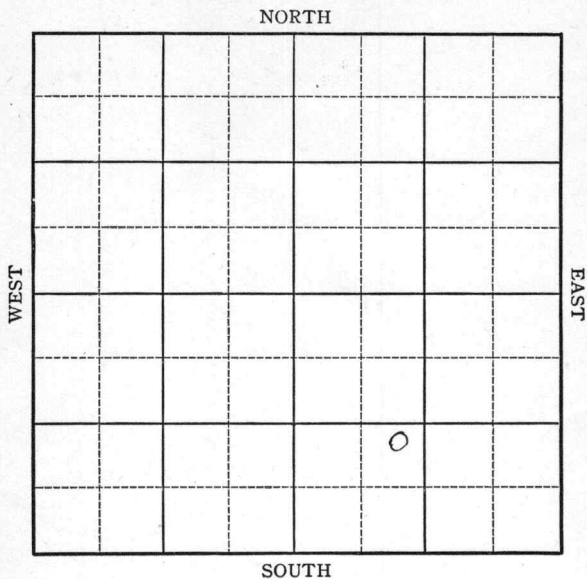

Map No. 17 Sec. 15 Twp. 23 R. 13EWell No. 22 ShadelO K O Oil & Gas

Company

Contractor

FIRST REPORT

NE SW SE

1400 Ft. from N. Line

Ft. from S. Line

Ft. from E. Line

1280 Ft. from W. Line

VIRGIL POOL

SECTION PLAT

		o	

Location

Rig up

Drilling and Remarks:

Machine

RECORD

Cased in. ft.

Sand

Gas

Oil

Total Depth

PRODUCTION

1st 24 hrs. Nat.

1st 24 hrs. after shot

Gas Cu. Ft.

Dry Hole

Abandoned

Date

JUN 25 1941

19

S. J. LEWIS

Scout

Map No. 17 Sec. 15 Twp. 23 R. 13EWell No. 22 Shadel0 K 0 Oil & Gas

Company

COMPLETED

Contractor

NE SW SE1400 Ft. from N. Line

Ft. from S. Line

Ft. from E. Line

1280 Ft. from W. Line

VIRGIL POOL

SECTION PLAT

		0	

Location

Rig up

Drilling and Remarks:

*Miss 1773**6" @ 1773**2000 acut**Pump 120 Ps**36 1/2 Gr*

RECORD

Cased _____ in., _____ ft.

Sand _____

Gas _____

Oil _____

Total Depth 1805

PRODUCTION

1st 24 hrs. Nat. _____

1st 24 hrs. after shot _____

Gas _____ Cu. Ft.

Dry Hole _____

Abandoned _____

Date

JUL 23 1941 19S. J. LEWIS Scout