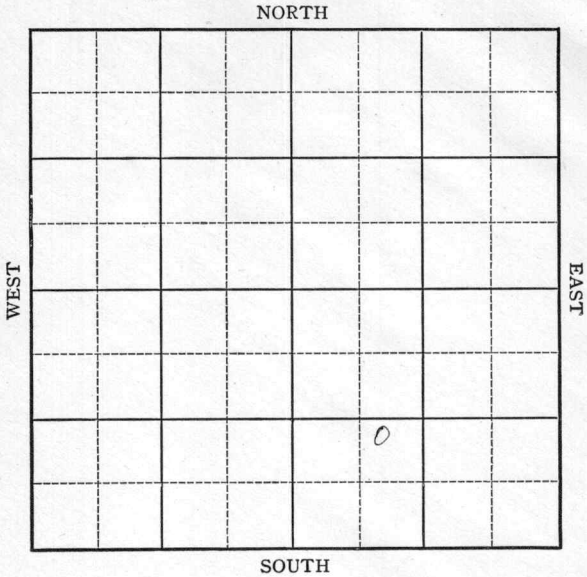


Section 15 Township 23 Range 13-EWell No. #21 ShadelCompany O K O
(Virgil)

Map No. 17 Sec. 15 Twp. 23 R. 13EWell No. 21 Shadel

O K O

Company

Contractor

FIRST REPORT

NE SW SE

1350 Ft. from N. Line Ft. from S. Line Ft. from E. Line780 Ft. from W. Line

VIRGIL POOL

SECTION PLAT

Location Rig up

Drilling and Remarks:

Drlg. 345

RECORD

Cased in., ft.Sand Gas Oil Total Depth

PRODUCTION

1st 24 hrs. Nat. 1st 24 hrs. after shot Gas Cu. Ft.Dry Hole Abandoned

Date

JUL 30 1941 19 S. J. LEWIS Scout

Map No. 17 Sec. 15 Twp. 23 R. 13EWell No. 21 Shadel

O K O

Company

COMPLETED

Contractor

NE SW SE

SECTION PLAT

1350 Ft. from N. Line

Ft. from S. Line

Ft. from E. Line

780 Ft. from W. Line

VIRGIL POOL

Location

Rig up

Drilling and Remarks:

*Miss 1748.**7" @ 1753**2000 acio**Pump 30 Bbl.*

RECORD

Cased _____ in., _____ ft.

Sand _____

Gas _____

Oil _____

Total Depth 1781

PRODUCTION

1st 24 hrs. Nat. _____

1st 24 hrs. after shot _____

Gas _____ Cu. Ft.

Dry Hole _____

Abandoned _____

Date

SEP 3 1941 19

S. J. LEWIS

Scout