

KANSAS


~~Coffey~~
Greenwood

Section 15 Township 23 Range 13E

Well No. 23 Shadel

Company R. E. French

Misc.
NORTH

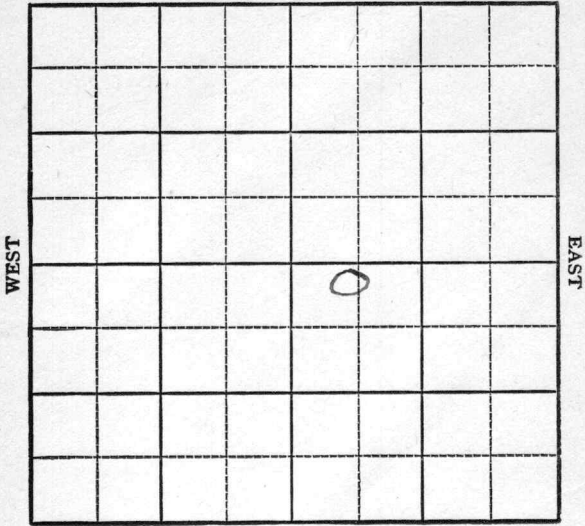

SOUTH

FILE

KANSAS

Greenwood
~~Coffey~~

Sec. 15 Twp. 23 R. 13E

Well No. 23 Shadel Farm

R E French Company


Misc.

200 Ft. from N. Line

Ft. from S. Line

Ft. from E. Line

660 Ft. from W. Line

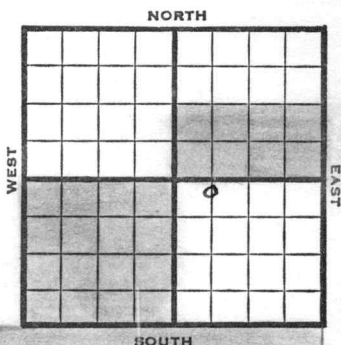

C N L NW .SE .

REPORT

1948

9/22

RUR

9/29

8-5/8" @ 60'

Drlg. 1580'

10/6

Miss 1755'

TD 1761'

5" @ 1753

WOC

10/13

Miss 1755'

5" @ 1753'

Pump 20 oil Pot.

Gr. 38°

TD 1770'

COMPLETED

Coffey County Kansas State
Map No. Sec. 15 Twp. 23 R. 13E

Well No. 23 Shadel

R. E. French Company

FIRST REPORT

Contractor

C N L NW SE


SECTION PLAT

200 Ft. from N. Line

Ft. from S. Line

Ft. from E. Line

660 Ft. from W. Line

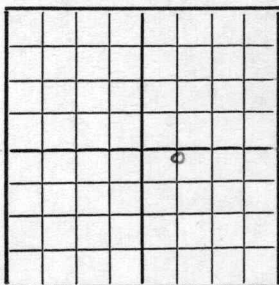

Miscellaneous

Remarks:

R U R

Date SEP 22 1948

Scout S. J. LEWIS

Map No. 17 Sec. 15 Twp. 23 R. 13E

Well No. 23 Shadel

R. E. French Company

COMPLETE Contractor

CN L- NW SE


SECTION PLAT

200 Ft. from N. Line

_____ Ft. from S. Line

_____ Ft. from E. Line

660 Ft. from W. Line

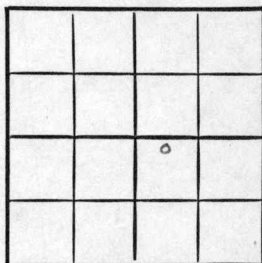

Greenwood County

Location _____

Rig up _____

Drilling and Remarks:

Misc 1755

5" @ 1753

Run 20 oil BT

382 44

RECORD

Cased _____ in., _____ ft.

Sand _____

Gas _____

Oil ☒ _____

Total Depth 1220

PRODUCTION

1st 24 hrs. Nat. _____

1st 24 hrs. after shot _____

Gas _____ Cu. Ft.

Dry Hole _____

Abandoned _____

Date

OCT 13 1948 19

S. J. LEWIS

Scout

Greenwood County Kansas State

Map No. 17 Sec. 15 Twp. 23 R. 13E

Well No. 23 Shadel

R. E. French Company

CORRECTION Contractor

C N L NW SE


SECTION PLAT

200 Ft. from N. Line

 Ft. from S. Line

 Ft. from E. Line

660 Ft. from W. Line

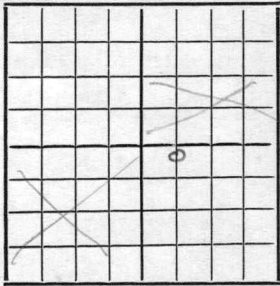

Miscellaneous

Remarks:

Reported in Coffey County

Date SEP 29 1948

Scout S. J. LEWIS