


Map No. 14 ans Sec. 28 Twp. 23 R. 10 ✓
Well No. 47 7 hall Farm
Roth + Mission Company

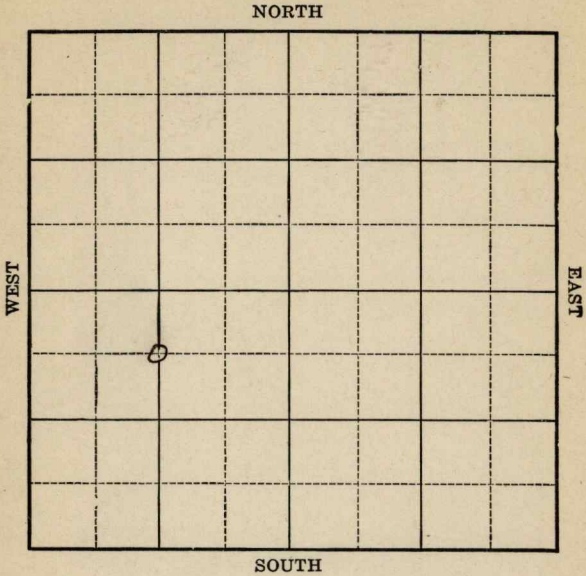

Location _____
Drilling Remarks _____

RECORD

Cased _____ in. _____ ft.
Sand _____
Gas _____
Oil _____
Total Depth _____

Rig Up _____
Drilling Remarks _____


PRODUCTION

1st 24 hrs. Nat. _____
1st. 24 hrs. after shot _____
Gas _____ cu. ft.
Dry Hole _____
Abandoned _____

Map No. Kansas Sec. 28 Twp. 23 R. 10Well No. 47 Thrall Farm
Roth & Mission Company760 Ft. from N. Line

Ft. from S. Line

Ft. from E. Line

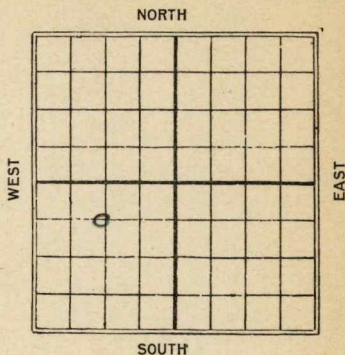1320 Ft. from W. Line

Date

REPORT

19253/24Rgn up5/1Top sand 23301st Oil 2337-2398T.D. 2403 150 gts75 Bbls

Map No. **10 KANSAS** Sec. **28** Twp. **23** R. **10**

Well No. **47 Thrall**

Roth & Mission Company

Contractor

FIRST REPORT


SECTION PLAT

760 Ft. from N. Line

_____ Ft. from S. Line

_____ Ft. from E. Line

1320 Ft. from W. Line

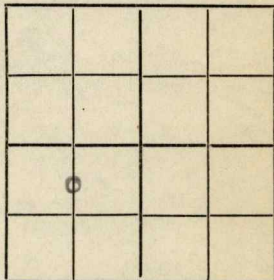

Location _____

Rig up _____

Drilling and Remarks:

Rig up

RECORD

Cased _____ in., _____ ft.

Sand _____

Gas _____

Oil _____

Total Depth _____

PRODUCTION

1st 24 hrs. Nat. _____

1st 24 hrs. after shot _____

Gas _____ Cu. Ft.

Dry Hole _____

Abandoned _____

Date

3/24 192 **5**

M. A. BENEAR Scout

Map No. 16 lands Sec. 28 Twp. 23 R. 10

Well No. 47 Thrall
mission oil & Leth Company

Contractor

COMPLETED


SECTION PLAT

760 Ft. from N. Line

_____ Ft. from S. Line

_____ Ft. from E. Line

1320 Ft. from W. Line

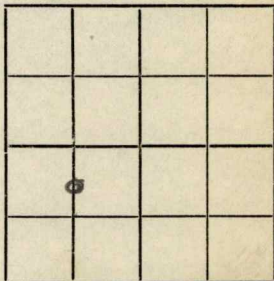

Location _____

Rig up _____

Drilling and Remarks:

Top 2330' 1st
oil 2337-2398'

152
75 b/s.

RECORD

Cased _____ in., _____ ft.

Sand _____

Gas _____

Oil _____

Total Depth 2403

PRODUCTION

1st 24 hrs. Nat. _____

1st 24 hrs. after shot _____

Gas _____ Cu. Ft.

Dry Hole _____

Abandoned _____

Date

MAY 1 1925

192

CHAS. L. SHERWOOD
 Scout