
Form 51 5M 8-24 16567

Map No. Kansas Sec. 28 Twp. 23 R. 10

Well No. 51 Thrall Farm

Roth Faurot & Missouri Company

NORTH

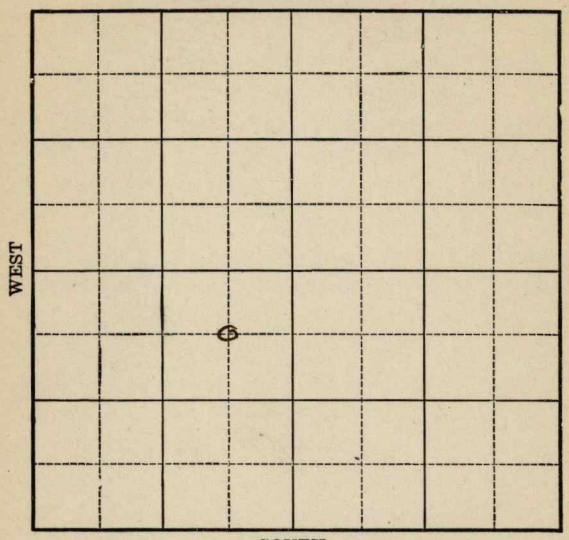

SOUTH

Location	Rig Up
Drilling Remarks	Drilling Remarks
RECORD	PRODUCTION
Cased in. ft.	1st 24 hrs. Nat.
Sand	1st. 24 hrs. after shot
Gas	Gas cu. ft.
Oil	Dry Hole
Total Depth	Abandoned

Form 252A 5M 8-24 16529

Map No. Kaw Sec. 28 Twp. 23 R 10

Well No. 51 Thrall Farm


Roth-Faurot & Mission Company

792 Ft. from N. Line

Ft. from S. Line

Ft. from E. Line

1848 Ft. from W. Line

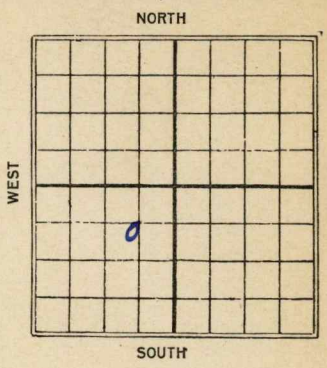

Date 1925	REPORT
6/12	Rigg up.
6/19	Dlg 400'
6/26	" 850
7/3	" 1630
7/10	2035
7/17	5 2407 Dr.
7/24	sand 2333-2407 - T.D. 2407'
	Pay 2374-2403'
	80/20 bbls.

Form 26—1M Bks.—3-23—11959.


Map No. 16 Sec. 28 Twp. 23 R. 10

Well No. 21 Thrall

Roth-Faust & Mission Company

Contractor

SECTION PLAT

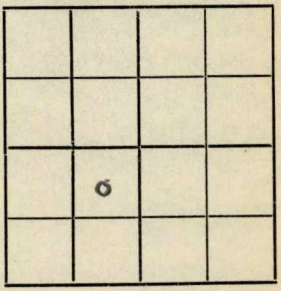

792 Ft. from N. Line

Ft. from S. Line

Ft. from E. Line

1848 Ft. from W. Line

FIRST REPORTS

Location

Rig up ✓

Drilling and Remarks:

RECORD

Cased in., ft.

Sand

Gas

Oil

Total Depth

PRODUCTION

1st 24 hrs. Nat.

1st 24 hrs. after shot

Gas Cu. Ft.

Dry Hole

Abandoned

Date

JUN 12 1925

192

CHAS. L. SHERWOOD

Scout

Form 26—1M Bks.—3-23—11959.


Map No. Kinder Sec. 28 Twp. 23 R. 10

Well No. 51 Hall

Roth-Laura L Mission Company

Contractor

SECTION PLAT

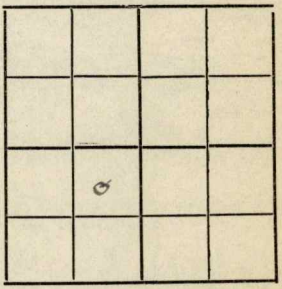

792 Ft. from N. Line

Ft. from S. Line

Ft. from E. Line

1848 Ft. from W. Line

Completed

Location

Rig up

Drilling and Remarks:

Ray 2374-2402'

80/20 bls

RECORD

Cased in., ft.

Sand 2332-2407'

Gas

Oil

Total Depth 2407'

PRODUCTION

1st 24 hrs. Nat.

1st 24 hrs. after shot

Gas Cu. Ft.

Dry Hole

Abandoned

Date

JUL 24 1925

192

CHAS. L. SHERWOOD

Scout