


Section 16 Township 23 Range 13E

Well No. ⁹~~#1~~ Schindler

Company Shaffer & Howell

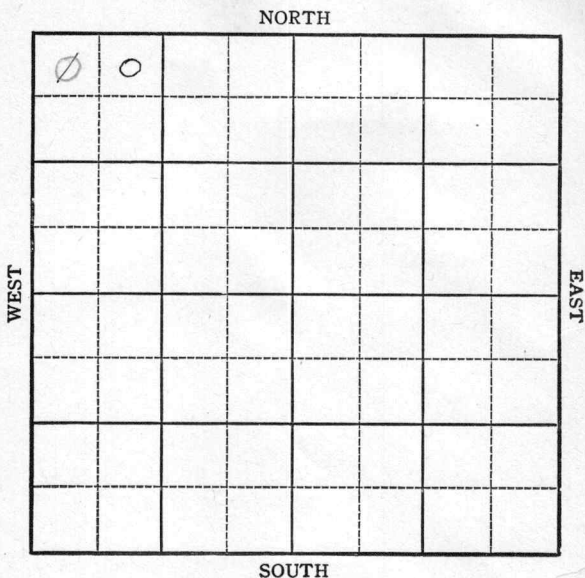

Sec. 16 Twp. 23 R. 13E

Well No. #1 Schindler Farm

Shaffer & Howell Company


Virgil

330 Ft. from N. Line

 Ft. from S. Line

 Ft. from E. Line

990
330 Ft. from W. Line

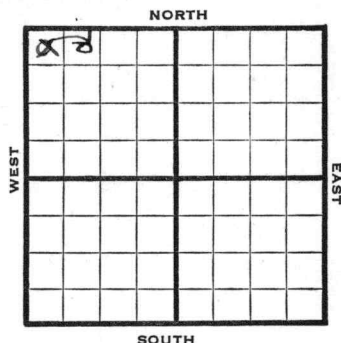

1944

R E P O R T

5/3 Location

5/10 Drlg. 300'

5/17 12" - 540
Drlg. 902

5/24 Drlg. 1345
10" @ 996

5/31 Drlg. 1495

6/7 8 " @ 1400
Miss. 1796
6" @ 1797
TD 1831-2000 acid.

6/14 Miss. 1796
6" @ 1797
2000 acid
TD 1831
Pump 40 Pot.
Grav. 38.0

COMPLETED


Pool Name VirgilMap No. 17 Sec. 16 Twp. 23 R. 13EWell No. 1 SchindlerShaffer & Howell Company

FIRST REPORT

Contractor

NW/C

SECTION PLAT

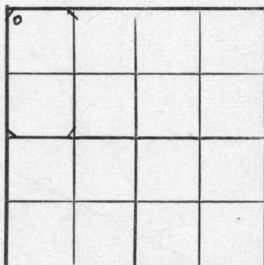330 Ft. from N. Line Ft. from S. Line Ft. from E. Line330 Ft. from W. LineGreenwood CountyLocation XRig up

Drilling and Remarks:

RECORD

Cased in., ft.Sand Gas Oil Total Depth

PRODUCTION

1st 24 hrs. Nat. 1st 24 hrs. after shot Gas Cu. Ft.Dry Hole Abandoned

Date

MAY 3 194419S. J. LEWIS Scout

Pool Name Virgil

KANSAS
 Map No. 17 Sec. 16 Twp. 23 R. 13E

Well No. 2 SchindlerShaffer & Howell

Company

CORRECTION

Contractor

NW/C

SECTION PLAT

0			

330 Ft. from N. Line Ft. from S. Line Ft. from E. Line330 Ft. from W. LineGreenwoodLocation Rig up

Drilling and Remarks:

Reported as
 #1 Schindler
 and drill site
 W $\frac{1}{2}$ NW

RECORDCased in., ft.Sand Gas Oil Total Depth **PRODUCTION**1st 24 hrs. Nat. 1st 24 hrs. after shot Gas Cu. Ft.Dry Hole Abandoned

Date

MAY 10 1944

19

S. J. LEWIS

Scout

KANSAS

Pool Name VirgilMap No. 1 Sec. 16 Twp. 23 R. 13EWell No. 2 SchindlerShaffer & Howell

Company

CORRECTION

Contractor


NE NW NW330 Ft. from N. Line

Ft. from S. Line

Ft. from E. Line

990 Ft. from W. Line

SECTION PLAT

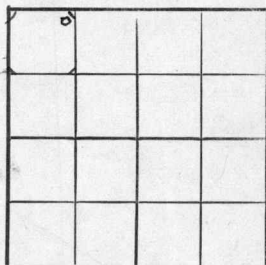

Greenwood County

Location

Rig up

Drilling and Remarks:

Reported NW/C

RECORD

Cased _____ in., _____ ft.

Sand _____

Gas _____

Oil _____

Total Depth _____

PRODUCTION

1st 24 hrs. Nat. _____

1st 24 hrs. after shot _____

Gas _____ Cu. Ft.

Dry Hole _____

Abandoned _____

Date

MAY 24 1944

19

S. J. LEWIS

Scout

Pool Name Virgil

Map No. 17 Sec. 16 Twp. 23 R. 13E

Well No. 2 Schindler

Shaffer & Howell Company

COMPLETED

Contractor

NE NW NW

SECTION PLAT

330 Ft. from N. Line

_____ Ft. from S. Line

_____ Ft. from E. Line

990 Ft. from W. Line

Greenwood County

Location _____

Rig up _____

Drilling and Remarks:

Miss 1796
6" @ 1797
2000 @ acid
Pump 40 P.D.
38° Gr

RECORD

Cased _____ in., _____ ft.

Sand _____

Gas _____

Oil _____

Total Depth 18.31

PRODUCTION

1st 24 hrs. Nat. _____

1st 24 hrs. after shot _____

Gas _____ Cu. Ft.

Dry Hole _____

Abandoned _____

Date

JUN 14 1944

19

S. J. LEWIS Scout