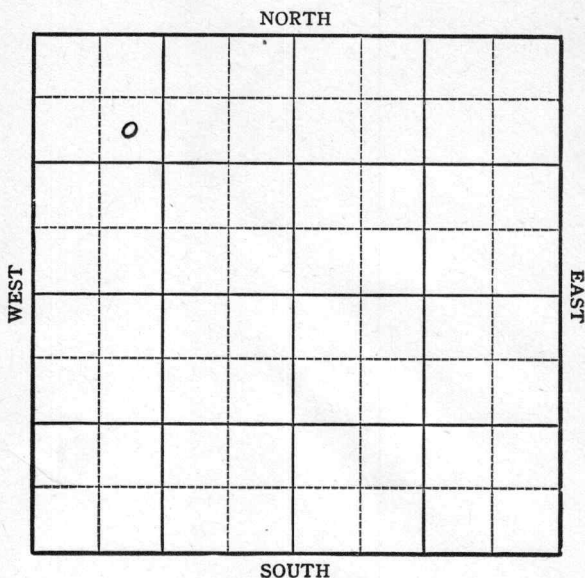


Section 16 Township 23 Range 13-E

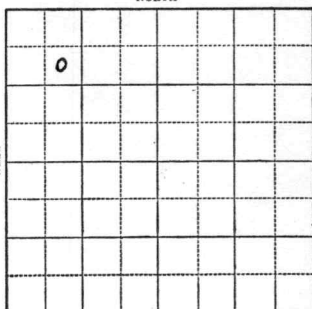
Well No. #2 Burris

Company Jackman et al



Sec. 16 Twp. 23 R. 13-EWell No. #2 Burris FarmJackman etal Company

NORTH

990 Ft. from N. Line Ft. from S. Line Ft. from E. Line990 Ft. from W. Line

1943

R E P O R T

9/15 Location

9/22 Machine

9/29 12" @ 18'

10/6 Drlg. 1260'

10/13 Miss 1776-80 T.D.
7" @ 1779'
Rust10/20 T.D. 1810
200' oil in 12 hrs.

10/27 2000 acid

11/3 Miss 1776
7" @ 1779
2000 acid
Pump 15 Pot.
T.D. 1810'
Gravity 39

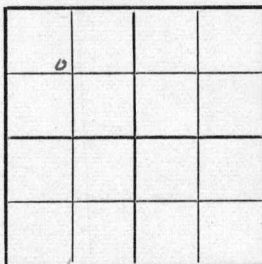
COMPLETED.

KANSAS

Map No. 17 Sec. 16 Twp. 23 R. 13EWell No. 2 BurrisJackman et al. CompanyFIRST REPORT Contractor

SE NW NW

SECTION PLAT

990 Ft. from N. Line Ft. from S. Line Ft. from E. Line990 Ft. from W. LineMiscellaneousLocation XRig up

Drilling and Remarks:

RECORD

Cased in., ft.Sand Gas Oil Total Depth

PRODUCTION

1st 24 hrs. Nat. 1st 24 hrs. after shot Gas Cu. Ft.Dry Hole Abandoned

Date

SEP 15 194319S. J. LEWISScout

KANSAS

Map No. 16 Sec. 23 Twp. R. 13E

Well No. 2 Burris

Jackman et al.

Company

COMPLETED

Contractor

SE NW NW

SECTION PLAT

990 Ft. from N. Line

Ft. from S. Line

Ft. from E. Line

990 Ft. from W. Line

Miscellaneous

Location

Rig up

Drilling and Remarks:



Date

NOV 3 1943 19

S. J. LEWIS Scout

RECORD

Cased in, ft.

Sand

Gas

Oil

Total Depth

PRODUCTION

1st 24 hrs. Nat.

1st 24 hrs. after shot

Gas Cu. Ft.

Dry Hole

Abandoned