KANSAS

FORM 51 5M 4-41 PETROL


Greenwood

Section 16 Township 23 Range 13-E

Well No. 3 Squder "B" (Sauder)

Company Shaffer & Howell

Virgil Pool

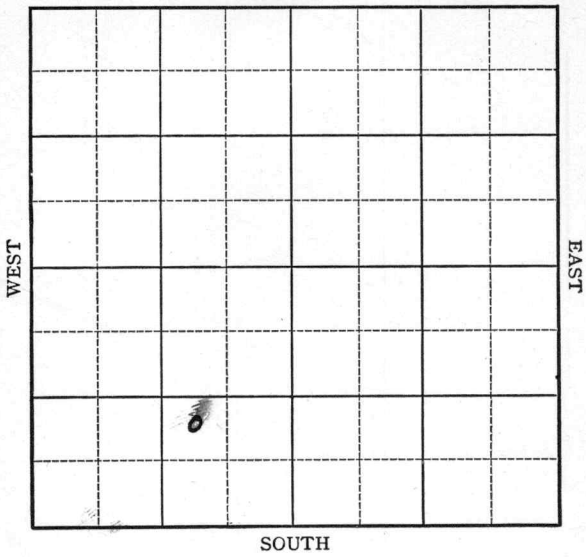

FORM 252-A 5M 1-41 PETROL KANSAS Greenwood

Sec. 16 Twp. 23 R. 13-E

Well No. #3 Souder "B" Farm

Shaffer & Howell Company


(Virgil)

_____ Ft. from N. Line

800 Ft. from S. Line

1020 Ft. from E. Line

_____ Ft. from W. Line

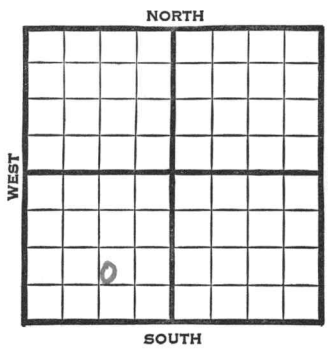

1941	REPORT
5/7	Drlg. 470'
5/15	12" - 475' Drlg. 900'
5/22	12" - 627' 10" - 900'
	8" - 1374' Drlg. 1520'
5/28	Miss. 1703' 6" - 1714'
	T.D. 1735' Swab 2 oil per hr.
6/5	" " " " "
6/11	Miss. 1703'
	6" - 1714'
	T.D. 1735'
	1000 acid.
	Potential 10 bbls., pump.
	38. Gravity
	COMPLETED

Form 26—200 Bks.—1-40—Palace Greenwood KANSAS

Map No. 17 Sec. 16 Twp. 23 R. 13E

Well No. 3 Souder "B"

Shaffer & Howell Company

FIRST REPORT Contractor

NW SE SW

_____ Ft. from N. Line


800 Ft. from S. Line

1020 Ft. from E. Line

_____ Ft. from W. Line

VIRGIL POOL

SECTION PLAT

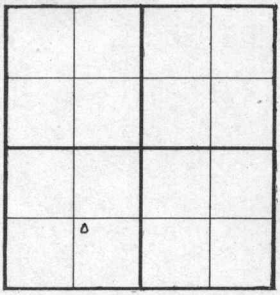

Location _____

Rig up _____

Drilling and Remarks:

Drlg. 470

RECORD

Cased _____ in., _____ ft.

Sand _____

Gas _____

Oil _____

Total Depth _____

PRODUCTION

1st 24 hrs. Nat. _____

1st 24 hrs. after shot _____

Gas _____ Cu. Ft.

Dry Hole _____

Abandoned _____

Date

MAY 7 1941

19 S. J. LEWIS Scout

Form 26—200 Bks.—1-40—Palace Greenwood KANSAS

Map No. 17 Sec. 16 Twp. 23 R. 13E

Well No. 3 Souder "B"

Shaffer & Howell Company

COMPLETED Contractor

NW SE SW

____ Ft. from N. Line


800 Ft. from S. Line

1020 Ft. from E. Line

____ Ft. from W. Line

VIRGIL POOL

SECTION PLAT

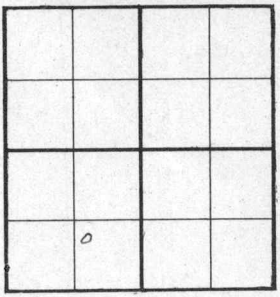

Location ____

Rig up ____

Drilling and Remarks:

Wiss 1703
6" @ 1714
1000 acid
Pump 10 BPH

35° Gr

RECORD

Cased ____ in., ____ ft.

Sand ____

Gas ____

Oil ____

Total Depth 1735'

PRODUCTION

1st 24 hrs.-Nat. ____

1st 24 hrs. after shot ____

Gas ____ Cu. Ft.

Dry Hole ____

Abandoned ____

Date

JUN 11 1941 19 S. J. LEWIS Scout