

Greenwood

KANSAS


Form 51—5M—11-38—Palace

Section 17 Township 23 Range 13-E

Well No. #2 Long

Company Shull Drilling

NORTH Virgil Pool

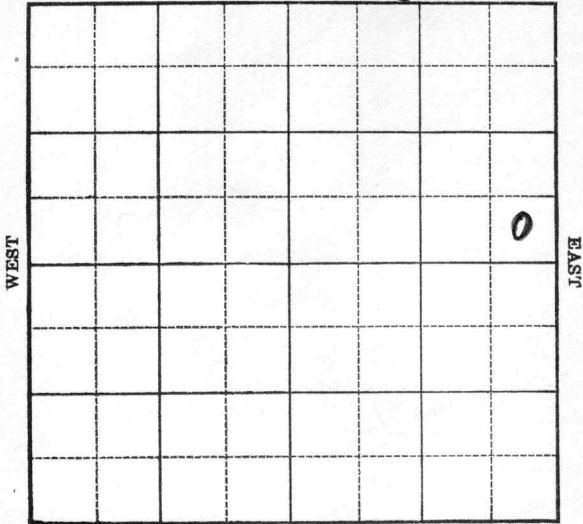


SOUTH

KANSAS

Greenwood

Sec. 17 Twp. 23 R. 13-EWell No. #2 Long FarmShull Drilling Company

Virgil

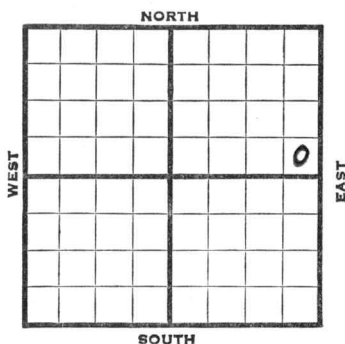 Ft. from N. Line330 Ft. from S. Line330 Ft. from E. Line Ft. from W. Line

1939	REPORT
1/4	12" - 550' . 10" - 957' .
	8" - 1378' . Miss. 1762' T.D.
	6" - 1762' . WOC.
1/13	T. D. 1787' . 2000 acid.
1/18	6" - 1762' .
	Miss. 1762' .
	T. D. 1787' .
	2000 acid.
	ABANDONED

Greenwood KANSAS

Map No. 17^M Sec. 17 Twp. 23 R. 13EWell No. 2 LongShull Drilling

Company

Contractor

FIRST REPORT

SE NE

 Ft. from N. Line330 Ft. from S. Line330 Ft. from E. Line Ft. from W. Line

VIRGIL POOL

SECTION PLAT

			0

Location Rig up

Drilling and Remarks:

12" - 55010" - 9578" - 1378Miss 1762 TD6" 1762WOC

RECORD

Cased in., ft.Sand Gas Oil Total Depth

PRODUCTION

1st 24 hrs. Nat. 1st 24 hrs. after shot Gas Cu. Ft.Dry Hole Abandoned

Date

JAN 4 - 1939 19H. D. Hatfield Scout

Map No. 17 Sec. 17 Twp. 23 R. 13EWell No. 2 LongShull Drilling

Company

Contractor

ABANDONED
SE NE Ft. from N. Line330 Ft. from S. Line330 Ft. from E. Line Ft. from W. Line

SECTION PLAT

			0

VIRGIL POOL

Location Rig up

Drilling and Remarks:

*2000 and**D & A*

RECORD

Cased 6 in., 1762 ft.Sand MISS 1762Gas Oil Total Depth 1787

PRODUCTION

1st 24 hrs. Nat. 1st 24 hrs. after shot Gas Cu. Ft.Dry Hole Abandoned

Date

JAN 18 1939

19

H. D. Hatfield Scout