

KANSAS Sedgwick

Section 18 Township 27 Range 2E

Well No. 5 Murdock


Company C R A

Eastborough

NORTH

WEST

EAST

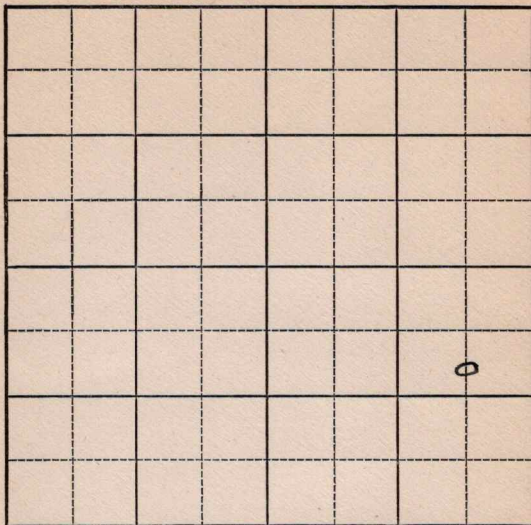

SOUTH

KANSAS

Sedgwick

Sec. 18 Twp. 27 R. 2E

Well No. #5 Murdock Farm

C R A

Company

(C R A, Cont.)


990' Ft. from N. Line

Ft. from S. Line

660' Ft. from E. Line

Ft. from W. Line

C S L NE SE

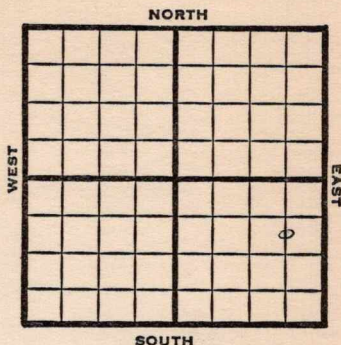

1949

Elev 1366'

REPORT

6/1 8" @ 80'
Drlg. 910'

6/7 KC 2508'
Miss 2982'
Drlg 3106'

6/15 Viola 3282'
Arb. 3412'
TD 3452'
Aband.

ABANDONED

Map No. _____ Sec. 18 Twp. 27 R. 2E

Well No. 5 Murdock

C R A

Company

C R A

Contractor

C S L N E S E


FIRST REPORT
SECTION PLAT

990 Ft. from N. Line

_____ Ft. from S. Line

660 Ft. from E. Line

_____ Ft. from W. Line

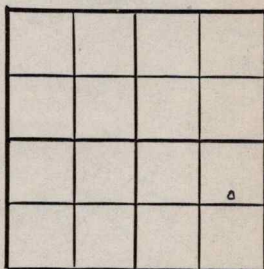

Sedgwick County

Location _____

Rig up _____

Drilling and Remarks:

8" @ 80

drlg. 910

RECORD

Cased _____ in., _____ ft.

Sand _____

Gas _____

Oil _____

Total Depth _____

PRODUCTION

1st 24 hrs. Nat. _____

1st 24 hrs. after shot _____

Gas _____ Cu. Ft.

Dry Hole _____

Abandoned _____

Date

JUN 1 1949

S. J. LEWIS Scout

Sedgwick County Kansas State

Map No. K12 Sec. 18 Twp. 27 R. 2E

Well No. 5 Murdock

C R A Company

ABANDONED Contractor

C S L N E S E


E1.1366
SECTION PLAT

990 Ft. from N. Line

 Ft. from S. Line

660 Ft. from E. Line

 Ft. from W. Line

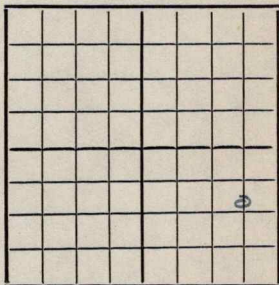

Eastborough Pool

Remarks:

Via la 3282

Q x 3412

X 03452.

Date JUN 15 1949

Scout S. J. LEWIS