


Form 51-5M-7-39-Palace

Section 17 Township 23 Range 13-E

Well No. #2 Bays

Company D. N. Rhoades

NORTH Virgil Pool

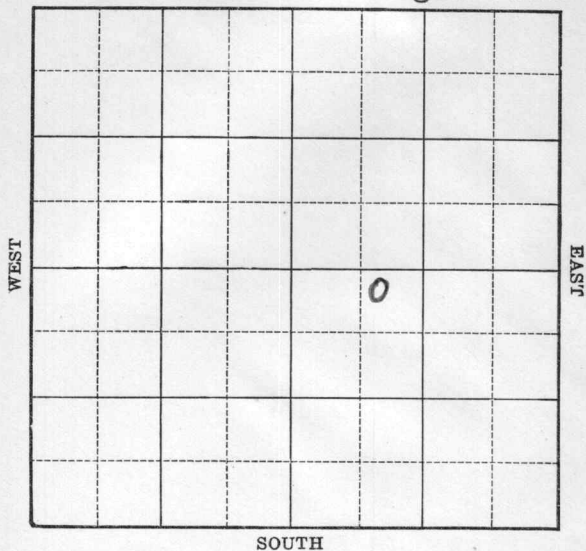


KANSAS

Greenwood

Sec. 17 Twp. 23 R. 13-EWell No. #2 Bays Farm
D. N. Rhoades Company

(Virgil)

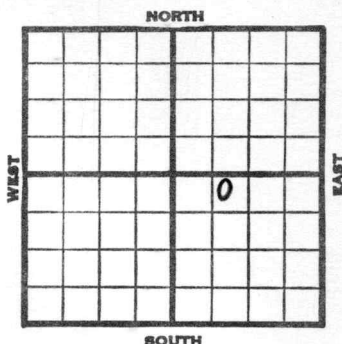250 Ft. from N. Line Ft. from S. Line Ft. from E. Line820 Ft. from W. Line

	REPORT
1939	
12/20	Machine.
12/28	"
1940	
1/4	"
1/11	"
1/18	"
1/25	"
2/1	"
2/8	"
2/15	"
2/23	"
2/29	"
3/8	"
3/14	Rigging up.
3/21	440' run 12".
3/28	12" - 440'
	Drlg. 940'
4/4	10" - 960' 8" - 1390'
	Drlg. 1480'
4/12	Chat. 1765-71' 6" - 1767'
	Miss. 1775-83' T.D.
	OVER

1940
4/17

Chat. 1765'

6" - 1767'

T.D. 1783'

2000 acid.

Pump 35 bbls.

COMPLETED

Map No. 17 Sec. 17 Twp. 23 R. 13EWell No. 2 BaysD. N. Rhoades

Company

Contractor

FIRST REPORT

SECTION PLAT


250 NE NW SE
Ft. from N. Line

Ft. from S. Line

Ft. from E. Line

820 Ft. from W. Line

VIRGIL POOL

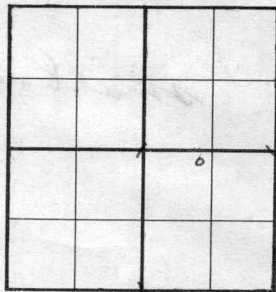

Location

Rig up

Drilling and Remarks:

Machine

RECORD

Cased _____ in., _____ ft.

Sand _____

Gas _____

Oil _____

Total Depth _____

PRODUCTION

1st 24 hrs. Nat. _____

1st 24 hrs. after shot _____

Gas _____ Cu. Ft.

Dry Hole _____

Abandoned _____

Date

DEC 20 1939

19

S. J. LEWIS

Scout

Map No. 17 Sec. 17 Twp. 23 R. 13EWell No. 2 BaysD. N. Rhoades

Company

Contractor

COMPLETED

SECTION PLAT

		0	

NE NW SE

250 Ft. from N. Line

Ft. from S. Line

Ft. from E. Line

820 Ft. from W. Line

VIRGIL POOL

Location

Rig up

Drilling and Remarks:

*Chas 1765**6" @ 1767.**2000 Acid**Pump 35 x 8 1/2*

RECORD

Cased _____ in., _____ ft.

Sand _____

Gas _____

Oil _____

Total Depth 1782

PRODUCTION

1st 24 hrs. Nat. _____

1st 24 hrs. after shot _____

Gas _____ Cu. Ft.

Dry Hole _____

Abandoned _____

Date

APR 17 1940 19S. J. LEWIS Scout