KANSAS


FORM 51 5M 10-41 PETROL

Kingman

Section 28 Township 29 Range 7-W

Well No. 1 Tredick

Company Stanolind

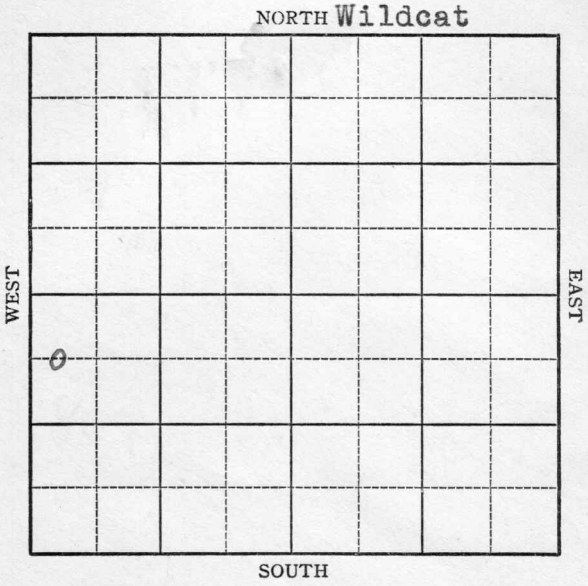

FORM 252-A 5M 6-41 PETROL KANSAS

Kingman

Sec. 28 Twp. 29 R. 7-W

Well No. #1 Tredick Farm

Stanolind Company

(Wildcat)


660 Ft. from N. Line

_____ Ft. from S. Line

_____ Ft. from E. Line

330 Ft. from W. Line

Elev. 1529

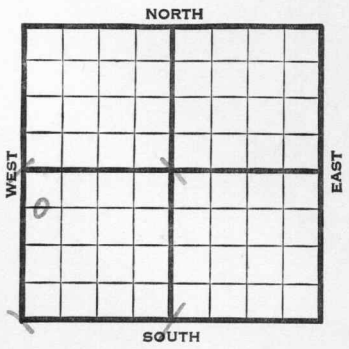

1942	REPORT
1/14	Location
1/22	"
1/29	"
2/5	Rotary.
2/12	13" - 265' Drlg. 840'
2/19	Drlg. 3105'
2/26	Lans. 3350' Drlg. 3957' No shows.
3/5	Miss. 4122' Kind. 4405'
	Misener 4518' Drlg. 4521'
3/11	Simpson 4519' 4519 1529 2990
	Arb. 4637'
	T.D. 4669'
	No shows.
	ABANDONED

Form 26 200 Bks. 5-41 McW. Kingman KANSAS

Map No. 36 Sec. 28 Twp. 29 R. 7W

Well No. 1 Tredrick

Stanolind Company

ABANDONED Contractor

C WL NW SW


660 Ft. from N. Line

Ft. from S. Line

Ft. from E. Line

330 Ft. from W. Line

SECTION PLAT

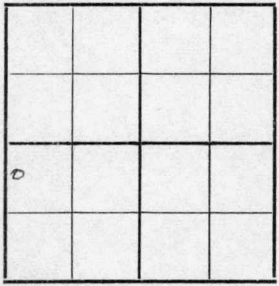

WILDCAT

Location

Rig up

Drilling and Remarks:

Simpson 4519
RT 4687
No shows

RECORD

Cased in., ft.

Sand

Gas

Oil

Total Depth 4669

PRODUCTION

1st 24 hrs. Nat.

1st 24 hrs. after shot

Gas Cu. Ft.

Dry Hole

Abandoned

Date

MAR 11 1942 19 S. J. LEWIS Scout

Form 26 200 Bks. 5-41 McW. Kingman KANSAS

Map No. 36 Sec. 28 Twp. 29 R. 7W

Well No. 1 Tredick

Stanolind Company

FIRST REPORT Contractor

C WL NW SW

660 Ft. from N. Line


Ft. from S. Line

Ft. from E. Line

330 Ft. from W. Line

WILDCAT

SECTION PLAT

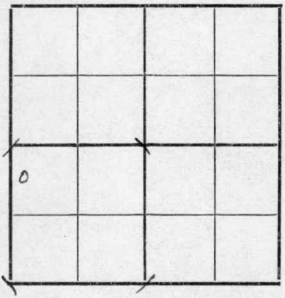

Location XX

Rig up

Drilling and Remarks:

RECORD

Cased in., ft.

Sand

Gas

Oil

Total Depth

PRODUCTION

1st 24 hrs. Nat.

1st 24 hrs. after shot

Gas Cu. Ft.

Dry Hole

Abandoned

Date

JAN 14 1942 19 S. J. LEWIS Scout