

KANSAS


FORM 51 5M 1-42 PETROL

Greenwood

Section 17 Township 23 Range 13-E

Well No. #6 Bays

Company Rhoads etal

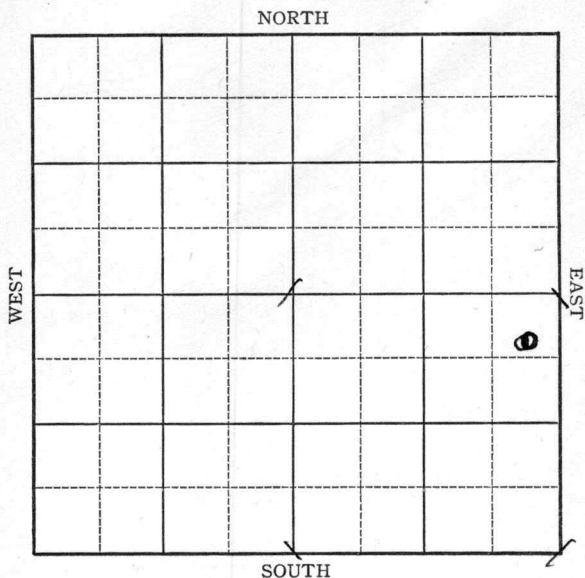


KANSAS

Greenwood

Sec. 17 Twp. 23 R. 13-EWell No. #6 Bays FarmRhoades eta. Company

Miscellaneous

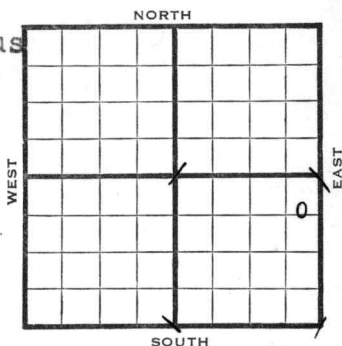550 Ft. from N. Line         Ft. from S. Line315 Ft. from E. Line         Ft. from W. Line

| 1943 | REPORT                                                                             |
|------|------------------------------------------------------------------------------------|
| 8/4  | Machine                                                                            |
| 8/11 | 15" @ 20'<br>Drig. 200'                                                            |
| 8/18 | 12" @ 460<br>Drig. 700'                                                            |
| 8/25 | 10" @ 958<br>Drig. 1000                                                            |
| 9/1  | 8" @ 1400'<br>Drig. 1768'                                                          |
| 9/8  | Miss 1775<br>T.D. 1791<br>6" @ 782                                                 |
| 9/15 | T.D. 1805 SO                                                                       |
| 9/22 | 1000 acid Pump 3 oil in 12 hrs.                                                    |
| 9/29 | Miss 1775<br>6" @ 1782'<br>4000 acid<br>Pump 10 Pot.<br>Gravity 36.5<br>T.D. 1805' |
|      | COMPLETED                                                                          |

KANSAS  
Map No. \_\_\_\_\_ Sec. 17 Twp. 23 R. 13EWell No. 6 BaysRhoades et al. Company

FIRST REPORT Contractor

C E L N E S E


550 Ft. from N. Line

\_\_\_\_\_ Ft. from S. Line

315 Ft. from E. Line

\_\_\_\_\_ Ft. from W. Line

## SECTION PLAT

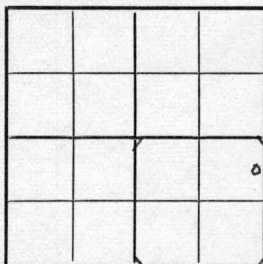

## MISCELLANEOUS

Location \_\_\_\_\_

Rig up \_\_\_\_\_

Drilling and Remarks:

Machine

## RECORD

Cased \_\_\_\_\_ in., \_\_\_\_\_ ft.

Sand \_\_\_\_\_

Gas \_\_\_\_\_

Oil \_\_\_\_\_

Total Depth \_\_\_\_\_

## PRODUCTION

1st 24 hrs. Nat. \_\_\_\_\_

1st 24 hrs. after shot \_\_\_\_\_

Gas \_\_\_\_\_ Cu. Ft.

Dry Hole \_\_\_\_\_

Abandoned \_\_\_\_\_

Date


AUG 4 1943 19 S. J. LEWIS Scout

KANSAS

Map No. 17 Sec. 17 Twp. 23 R. 13EWell No. 6 BoysRhoades et al. CompanyCOMPLETED Contractor

C E L N E S E

## SECTION PLAT

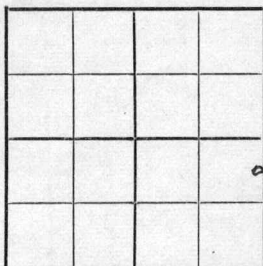550 Ft. from N. Line       Ft. from S. Line315 Ft. from E. Line       Ft. from W. Line

## Miscellaneous

Location                                 Rig up                                 

Drilling and Remarks:

*March 1995**6" @ 1782.**4000 acid**Pump 10 Psd**365 Lr*

## RECORD

Cased            in.,            ft.Sand                                 Gas                                 Oil                                 Total Depth 1825

## PRODUCTION

1st 24 hrs. Nat. 1111st 24 hrs. after shot                                 Gas                                  Cu. Ft.Dry Hole                                 Abandoned                                 

Date

SEP 29 1943

19

S. J. LEWIS

Scout