


Map No. **KANSAS** Sec. *19* Twp. *27* R. *2E*
Well No. *5-Eastborough* Farm
Derby Oil Company

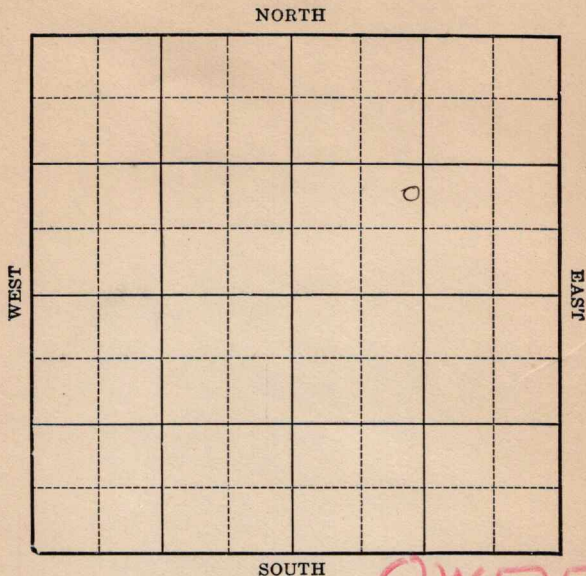

Location _____
Drilling Remarks _____

Rig Up _____
Drilling Remarks _____

RECORD


Cased _____ in. _____ ft.
Sand _____
Gas _____
Oil _____
Total Depth _____

PRODUCTION

1st 24 hrs. Nat. _____
1st 24 hrs. after shot _____
Gas _____ cu. ft.
Dry Hole _____
Abandoned _____

Map No. KANSAS Sec. 19 Twp. 27 R. 2^E
Well No. 5 - Eastborough Farm
Derby Oil Company

 Ft. from N. Line
995 Ft. from S. Line
1378 Ft. from E. Line
1931 Ft. from W. Line

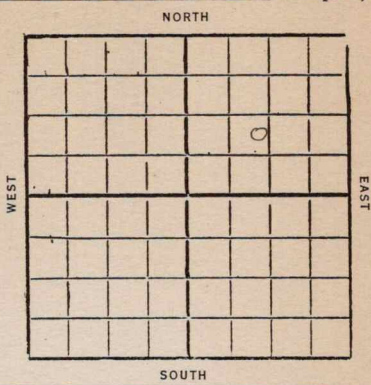

Date	REPORT
3/4	<u>Lac</u>
3/11	<u> </u>
3/18	<u> </u>
3/25	<u> </u>
4/1	<u> </u>
4/8	<u> </u>
4/15	<u> </u>
4/22	<u> </u>
4/29	<u>Bludg rig</u>
5/6	<u>Spdg</u>
5/13	<u>drlg 830'</u>
5/20	<u>12"-1176</u>
	<u>Drlg 1320'</u>
5/27	<u>10"-1945'</u>
6/3	<u>Top chat 2952'</u>
	<u>set 6"</u>
6/10	<u>TD 2971</u>
	<u>1600' oil in hole</u>
	<u>Oily out</u>
6/17	<u>Chat 2952-71</u>
	<u>TD 2971</u>
	<u>Made 165 bbl oil & 170 water</u>
	<u>(over) Comp</u>

1931

OWDD

755647
755654

8/5-

Top Chat 2952

Old T.D. 2971

Rgn up

8/12- Drlg 3060'

8/19- Cement cave 3190'

8/26- Fishing 3190'

9/2- T.D. 3190

drlg out cem

9/9- T.D. 3194' Fishing

9/16- T.D. 3194

drlg by tools

9/23

9/30- T.D. 3194 fsg tools

10/7

10/14

10/21

10/28

11/4-

T.D. 3194

P.B. to 2971'

11/11-

Top Chat 2952

T.D. 3194

P.B. to 2971

Pump 72 bbl oil
Comp.

Map No. KANSAS Sec. 19 Twp. 27 R. 2EWell No. 5 EastboroughPerry Oil Company

Contractor

SECTION PLAT

_____ Ft. from N. Line

995 Ft. from S. Line1378 Ft. from E. Line

_____ Ft. from W. Line

FIRST REPORTS

Location ✓

Rig up _____

Drilling and Remarks:

RECORD

Cased _____ in., _____ ft.

Sand _____

Gas _____

Oil _____

Total Depth _____

PRODUCTION

1st 24 hrs. Nat. _____

1st 24 hrs. after shot _____

Gas _____ Cu. Ft.

Dry Hole _____

Abandoned _____

Date

MAR 4 1931

19

S. J. LEWIS Scout

12 **KANSAS**

Map No. Sec. 19 Twp. 27 R. 2 E

Well No. 5 Eastbarrow

Derby Oil Co. Company

Contractor

COMPLETE**SECTION PLAT**

Ft. from N. Line

995 Ft. from S. Line

1378 Ft. from E. Line

Ft. from W. Line

		0	

Location

Rig up

Drilling and Remarks:

Chat 2952-2971

165 lbs oil
170 " water**RECORD**

Cased in., ft.

Sand

Gas

Oil

Total Depth 2971

PRODUCTION

1st 24 hrs. Nat.

1st 24 hrs. after shot

Gas Cu. Ft.

Dry Hole

Abandoned

Date

JUN 17 1931

CHAS. L. SHERWOOD

192

Scout

Seagwick

12 KANSAS

Map No. Sec. 19 Twp. 27 R. 2^E

Well No. 5 Eastborough

Derby Oil Co

Company

Contractor

FIRST REPORTS

SECTION PLAT

Ft. from N. Line

995 Ft. from S. Line

1378 Ft. from E. Line

Ft. from W. Line

"OW 00"

		0	

Location

T Chat 2954

Rig up

TD 2971'

Drilling and Remarks:

Rigging up

RECORD

Cased.....in.,ft.

Sand.....

Gas.....

Oil.....

Total Depth.....

PRODUCTION

1st 24 hrs. Nat.....

1st 24 hrs. after shot.....

Gas.....Cu. Ft.

Dry Hole.....

Abandoned.....

Date

AUG 5 1931

192

CHAS. L. SHERWOOD

Scout

Seagwick

12 **KANSAS** Sec. 19 Twp. 27 R. 2^EWell No. 5 Eastborough
Derby Oil Co Company

Contractor

COMPLETED**SECTION PLAT**

Ft. from N. Line

995 Ft. from S. Line

1378 Ft. from E. Line

Ft. from W. Line

		0	

Location

Rig up

Drilling and Remarks:

PB To 2971

Pump 72 Bls.

RECORD

Cased in., ft.

Sand Top Chat 2952

Gas

Oil

Total Depth 3194

PRODUCTION

1st 24 hrs. Nat.

1st 24 hrs. after shot

Gas Cu. Ft.

Dry Hole

Abandoned

Date

NOV 10 1931

192

CHAS. L. SHERWOOD

Scout