

Map No. _____ Sec. 27 Twp. 23 R. 10

Well No. 18 Thrall Farm

Well No. 18 Thrall Farm
Mission Oil Company

NORTH

WEST

EAST

SOUTH

Location _____

Drilling Remarks:

Rig up _____

Drilling Remarks:

RECORD

Cased _____ in. _____ ft.

Sand _____

Gas _____

Oil _____

Total Depth_____

PRODUCTION

1st 24 hrs Nat. _____

1st 24 hrs. after shot_____

Gas _____ cu. ft.

Dry Hole _____

Abandoned _____

Map No. _____ Sec. 29 Twp. 23 R. 10
 Well No. 18 Thrall Farm _____
Mission Oil Company _____

NORTH

_____ Ft. from N. Line


200 Ft. from S. Line

760 Ft. from E. Line

_____ Ft. from W. Line

WEST

EAST

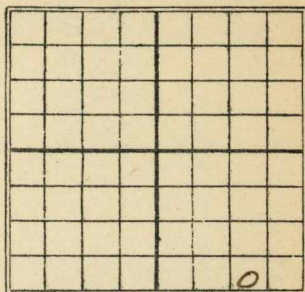

SOUTH

REPORT

Date

1923
3/22 Reg.
6/10 J. & J. 2250. Pay 2265-
2328- shot 170 gts. 175
Boh. J. & J. 2333'

Map No. **KANSAS** ¹⁶ Sec. **29** Twp. **23** R. **10**Well No. **18 Thrall****Mission Oil** Company

Contractor

FIRST REPORT

SECTION PLAT

-----Ft. from N. Line

200

-----Ft. from S. Line

760

-----Ft. from E. Line

-----Ft. from W. Line

			0

Location -----

Rig up -----

Drilling and Remarks:

RECORD

Cased ----- in., ----- ft.

Sand -----

Gas -----

Oil -----

Total Depth -----

PRODUCTION

1st 24 hrs. Nat. -----

1st 24 hrs. after shot -----

Gas ----- Cu. Ft.

Dry Hole -----

Abandoned -----

Date

M. A. BENEAR**MAR 22 1923****192**

Scout

Form 26—1M BKS.—3-25
Map No. KANSAS Sec. 29 Twp. 23 R. 10
Well No. 187 Hall
Mission Oil Company
Contractor

COMPLETED SECTION PLAT

_____ Ft. from N. Line

200 Ft. from S. Line

760 Ft. from E. Line

_____ Ft. from W. Line

			0

Location _____

Rig up _____

Drilling and Remarks:

Tap 1.2250
pay {2265-
2328

210.2333'

170/175 H

RECORD

Cased _____ in., _____ ft.

Sand _____

Gas _____

Oil _____

Total Depth _____

PRODUCTION

1st 24 hrs. Nat. _____

1st 24 hrs. after shot _____

Gas _____ Cu. Ft.

Dry Hole _____

Abandoned _____

Date

JUN 10 1923

M. A. BENEAR

192

Scout