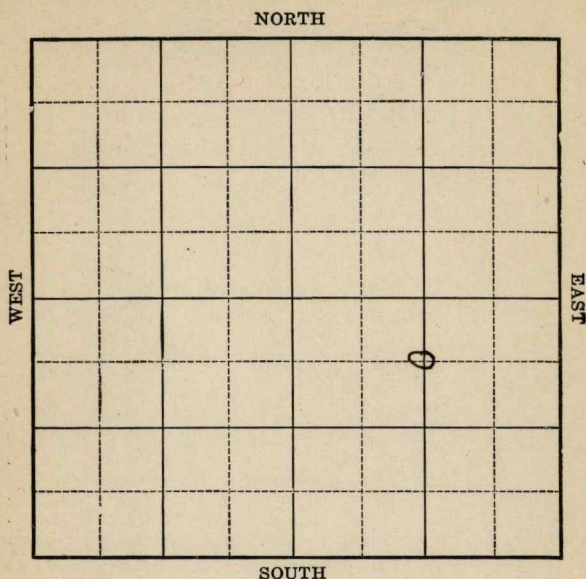


Map No. Kansas Sec. 29 Twp. 23 R. 10Well No. 54 Thrall FarmRoth - Faurot + Mission Company

Location _____

Drilling Remarks _____

Rig Up _____

Drilling Remarks _____

RECORD

Cased _____ in. _____ ft.

Sand _____

Gas _____

Oil _____

Total Depth _____

PRODUCTION

1st 24 hrs. Nat. _____

1st. 24 hrs. after shot _____


Gas _____ cu. ft.

Dry Hole _____

Abandoned _____

Map No. Kansas Sec. 29 Twp. 23 R. 10Well No. 54 Thall FarmRoth Fawcett Mission Company

Ft. from N. Line

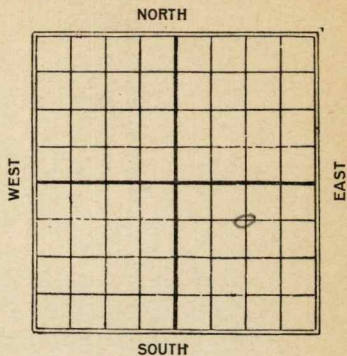1848 Ft. from S. Line1320 Ft. from E. Line1320 Ft. from W. Line

C.

Date


REPORT

19255/1R.O.G.5/29Running 10" 12506/5SL 16506/1223206/182345-2410 30 gals15 Bbls

Map No. 154nd Sec. 29 Twp. 23 R. 10Well No. 54 ThreeLoth-Hurston Company

Contractor

SECTION PLAT

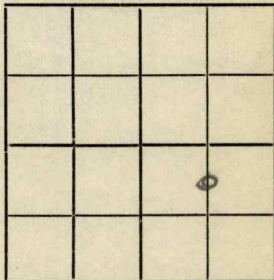

Ft. from N. Line

1848 Ft. from S. Line1320 Ft. from E. Line1320 Ft. from W. Line

FIRST REPORTS

Location

Rig on blow

Drilling and Remarks:

RECORD

Cased _____ in., _____ ft.

Sand _____

Gas _____

Oil _____

Total Depth _____

PRODUCTION

1st 24 hrs. Nat. _____

1st 24 hrs. after shot _____

Gas _____ Cu. Ft.

Dry Hole _____

Abandoned _____

Date

MAY 8 1925

CHAS. L. SHERWOOD

192

Scout

Map No. 16 Sec. 29 Twp. 23 R. 10

Well No. 54 3400

Roth-Forest & Mission Company

Contractor

COMPLETED


SECTION PLAT

_____ Ft. from N. Line

1848 Ft. from S. Line

1320 Ft. from E. Line

_____ Ft. from W. Line

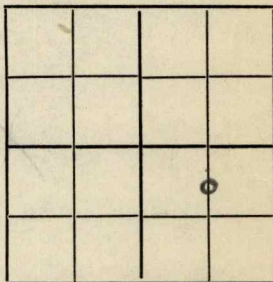

Location _____

Rig up _____

Drilling and Remarks:

Plugged Back
To 2387'

30/15 b/s

RECORD

Cased _____ in., _____ ft.

Sand 2345-2410'

Gas _____

Oil _____

Total Depth 2410'

PRODUCTION

1st 24 hrs. Nat. _____

1st 24 hrs. after shot _____

Gas _____ Cu. Ft.

Dry Hole _____

Abandoned _____

Date

JUN 18 1925

CHAS. L. SHERWOOD

192

Scout