


Form 51-5M-2-29-34703

Map No. Sedwick 19 27 2^E
KANSAS Sec. Twp. R.

Well No. 1-A Eastborough Farm
Derby Oil Company

NORTH

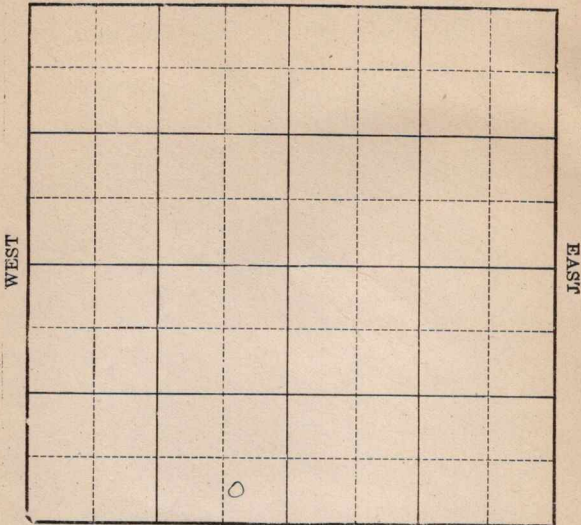

Location _____

Drilling Remarks _____

Rig Up _____

Drilling Remarks _____

RECORD

Cased _____ in. _____ ft.

Sand _____

Gas _____

Oil _____

Total Depth _____

PRODUCTION

1st 24 hrs. Nat. _____

1st 24 hrs. after shot _____

Gas _____ cu. ft.

Dry Hole _____

Abandoned _____


Sedgwick

Map No. **KANSAS** Sec. *19* Twp. *27* R. *2^E*

Well No. *1-A Eastborough* Farm

Derby Oil Company

NORTH

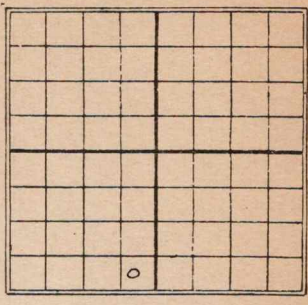

..... Ft. from N. Line

330 Ft. from S. Line

495 Ft. from E. Line

..... Ft. from W. Line

1930

Date

REPORT

Date	REPORT
<i>8/6</i>	<i>Bldg rig</i>
<i>8/13</i>	<i>Spud.</i>
<i>8/20</i>	<i>dry 770'</i>
<i>8/27</i>	<i>" 1520'</i>
<i>9/3</i>	<i>" 2390'</i>
<i>9/10</i>	<i>" 2890'</i>
<i>9/17</i>	<i>Chat 2971-94</i>
	<i>swab 751 bbl oil</i>
	<i>& 45 " water</i>
	<i>14 hrs</i>
<i>9/24</i>	<i>Chat 2971-94</i>
	<i>T.D. 2994</i>
	<i>swab 150 bbl oil</i>
	<i>and 75 " water</i>
	<i>Comp.</i>

Map No. **KANSAS** Sec. 19 Twp. 27 R. 25

Well No. 1 A Eastborough

Terry Oil Company

Contractor

SECTION PLAT

_____ Ft. from N. Line

330 Ft. from S. Line

495 Ft. from E. Line

_____ Ft. from W. Line

TWIN #1

FIRST REPORTS

Location _____

Rig up _____

Drilling and Remarks:

Building rig

RECORD

Cased _____ in., _____ ft.

Sand _____

Gas _____

Oil _____

Total Depth _____

PRODUCTION

1st 24 hrs. Nat. _____

1st 24 hrs. after shot _____

Gas _____ Cu. Ft.

Dry Hole _____

Abandoned _____

Date

AUG 6 1930

19

S. J. LEWIS Scout

Map No. 12 **KANSAS** Sec. 19 Twp. 27 R. 2E

Well No. 17 Eastborough East

Henry Oil Company

Contractor

SECTION PLAT

_____ Ft. from N. Line

330 Ft. from S. Line

495 Ft. from E. Line

_____ Ft. from W. Line

COMPLETED

Location _____

Rig up _____

Drilling and Remarks:

Chart 2971-94

swab 150 ft

75 ft water

RECORD

Cased _____ in., _____ ft.

Sand _____

Gas _____

Oil _____

Total Depth 2994

PRODUCTION

1st 24 hrs. Nat. _____

1st 24 hrs. after shot _____

Gas _____ Cu. Ft.

Dry Hole _____

Abandoned _____

Date

SEP 24 1930

S. J. LEWIS Scout