

Map No. KANSAS Sec. 30 Twp. 23 R. 10
Well No. 3- Martindale Farm
Roth & Fourat Company

NORTH

WEST

EAST

SOUTH

Location _____

Drilling Remarks

Rig Up _____

Drilling Remarks

RECORD

Cased _____ in. _____ ft.

Sand _____

Gas_____

Oil _____

Total Depth_____

PRODUCTION

1st 24 hrs. Nat. _____

1st 24 hrs. after shot_____


Gas _____ cu. ft. _____

Dry Hole_____

Abandoned _____

Map No. KANSAS Sec. 30 Twp. 23 R. 10^E
Well No. 3 - Martindale Farm
Roth & Tourat Company

 Ft. from N. Line
330 Ft. from S. Line
330 Ft. from E. Line
 Ft. from W. Line

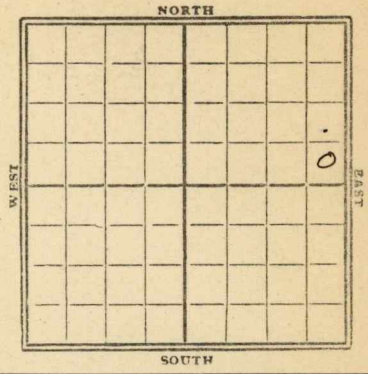

1929

Date	REPORT
9/18	Big bldg.
9/25	Blgn up.
10/2	Spdy.
10/19	Wrlly 925'
10/15	" 1450'
10/23	set 6" - 2014'
10/30	sand 2358-63'
	small show
	S.D. 2370'
11/6	Sand 2358-63'
	T.D. 2370'
	shot 7 yds
	20 bbls oil
	5 comp.

16 **KANSAS** Sec. 30 Twp. 23 R. 10^E
 Well No. 3 Martindale
 Roth & Jaurat Company

Contractor

FIRST REPORTS**SECTION PLAT**

Ft. from N. Line

330 Ft. from S. Line

330 Ft. from E. Line

Ft. from W. Line

			0

Location

Rig up

Drilling and Remarks:

Bleg Rig

RECORD

Cased in., ft.

Sand

Gas

Oil

Total Depth

PRODUCTION

1st 24 hrs. Nat.

1st 24 hrs. after shot

Gas Cu. Ft.

Dry Hole

Abandoned

Date

SEP 18 1929

192

CHAS. L. SHERWOOD

Scout

Sawwood

16 KANSAS Map No. Sec. 30 Twp. 23 R. 10

Well No. 3 Martindale

Roth & Jaurat Company

Contractor

COMPLETE

SECTION PLAT

Ft. from N. Line

330 Ft. from S. Line

330 Ft. from E. Line

Ft. from W. Line

			0

Location

Rig up

Drilling and Remarks:

7/20 Bls.

RECORD

Cased in, ft.





PRODUCTION

1st 24 hrs. Nat.

1st 24 hrs. after shot

Gas Cu. Ft.

Dry Hole

Abandoned

Date

NOV 6 1929

CHAS. L. SHERWOOD

192

Scout