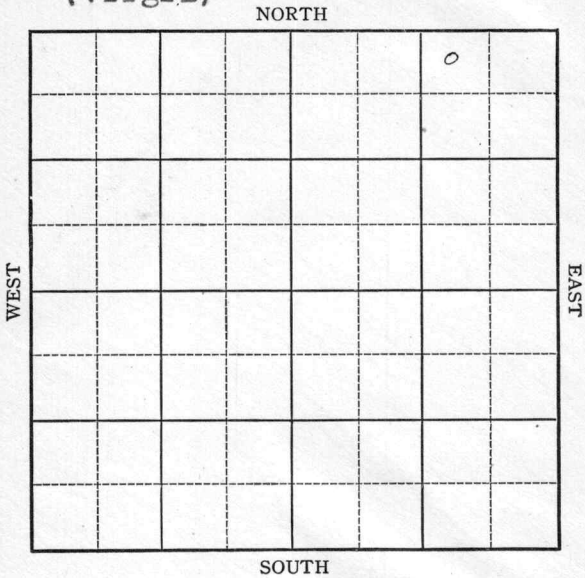



KANSAS

FORM 51 5M 4-41 PETROL

Section 4 Township 23 Range 13-EWell No. #1 InthurnCompany James Henderson
(Virgil)

Sec. 4 Twp. 23 R. 13-EWell No. #1 Inthurn FarmJames Henderson Company

(Virgil)

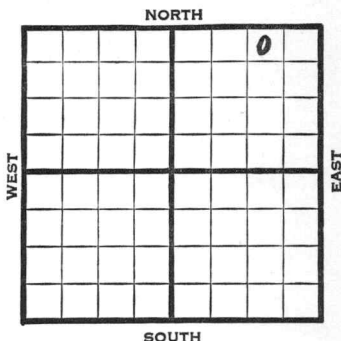330' Ft. from N. Line Ft. from S. Line990' Ft. from E. Line Ft. from W. Line

1941

REPORT

7/30

Machine

8/7

Drl g. 370'

8/15

12" 675 10" 1005 Dlg. 1020

8/21

8" - 1516' Drl g. 1555'

8/28

Miss. 1797' T.D. 1815'

Run 6".

9/4

Shot 20 qts. 1805-10'

50' oil 24 hours.

9/10

Miss. 1797'

6" - 1802'

T.D. 1815'

Shot 20 qts. 1805-10'

2000 acid.

Water.

ABANDONED

KANSAS

Map No. 17 Sec. 4 Twp. 23 R. 13EWell No. 1 InthurnJames Henderson

Company

Contractor

FIRST REPORT

NW NE NE

330 Ft. from N. Line Ft. from S. Line990 Ft. from E. Line Ft. from W. Line

VIRGIL POOL

SECTION PLAT

			0

Location Rig up

Drilling and Remarks:

Machine

RECORD

Cased in., ft.Sand Gas Oil Total Depth

PRODUCTION

1st 24 hrs. Nat. 1st 24 hrs. after shot Gas Cu. Ft.Dry Hole Abandoned

Date

JUL 30 1941 19

S. J. LEWIS

Scout

Map No. 17 Sec. 4 Twp. 23 R. 13EWell No. 1 InthurnJames Henderson CompanyABANDONED Contractor

SECTION PLAT

NW NE NE

330 Ft. from N. Line Ft. from S. Line990 Ft. from E. Line Ft. from W. Line

			0

VIRGIL POOL

Location Rig up

Drilling and Remarks:

*Miss 1797**6" @ 1802.**20 gals 1805-10**2000 acid**Water*

RECORD

Cased in., ft.Sand Gas Oil Total Depth 1815

PRODUCTION

1st 24 hrs. Nat. 1st 24 hrs. after shot Gas Cu. Ft.Dry Hole Abandoned

Date

SEP 10 1941 19S. J. LEWIS Scout