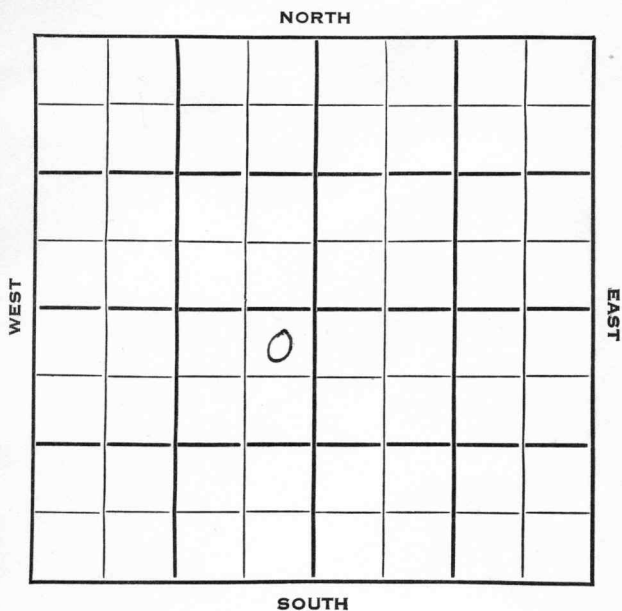


Section 20 Township 29 Range 32WWell No. #1 KelmanCompany Kansas-Nebraska Natural Gas

Haskell

KANSAS

SEC.	20	TWP.	29	R.	32 W
------	----	------	----	----	------

WELL NO.

1 Kelman

FARM

COMPANY

Kansas Nebraska Natural Gas.

CONTRACTOR

150 Hugoton Pool

Ft. from N. Line


Ft. from S. Line

150

Ft. from E. Line

Ft. from W. Line

NE NE SW

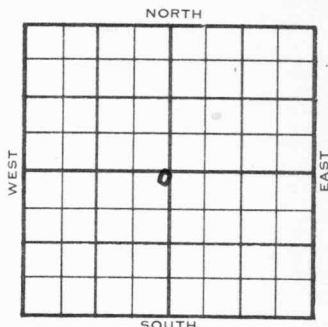

1953

ELEVATION

2917'

REPORT

12/9

Location

12/16

10" @ 598' w/400 sks
Drlg 2572'

1954

1/20

Spud 12-9-53

Gas Well

TD 2730'

10-3/4" @ 598'

Her. 2645', Kri 2667', Win 2720'

7" @ 2721'

CO to 2730', 1000A

PB 2700

132/2670-92, 1000A SSG 2000A

438,000 gas, frac, 3000A

CO to 2730, 12000A wtr.

PB 2724 wtr, PB 2704

Comp. 4 1/2 mcf/gpd

COMPLETED

County **Haskell** State **Kansas**

Sec. 20 (Blk. Twp.) 29 (Sur. Rge.) 32W Map No.

Operator Kansas-Nebraska Natural Gas

Well No. **1** Farm **Kelman**

Elev.	Location	NE	NE	SW
-------	----------	----	----	----

150 Ft. From N Line SW

150 Ft. From E Line Quarter

1st. Report DEC 9 1953

Completion

Remarks

Spudding Date _____

Drlg. Data Hugoton Pool

Location

J. G. McGEHEE

County Haskell State Kansas
 Sec. 20 (Blk. 29 (Sur. 32W Map No.
 (Twp.) (Rge.)
 Operator Kansas Natural Gas
 Well No. 1 Farm Kelman
 Elev. 2917 Location NE NE SW

COMPLETE									

150 Ft. From N Line SW
150 Ft. From E Line Quarter

1st. Report

Completion JAN 20 1954

Remarks Hugoton Pool

Spudding Date 12-9-53

Drlg. Data Gas well TD 2730

10 3/4" @ 598 Her. 2645 Kri. 2667

Win. 2720 7" @ 2721 CO to 2730

1000 A PB 2700 132/ 2670-92 1000 A

SSG 2000 A 438,000 gas frac

3000 A CO to 2730 12000 A wtr.

PB 2724 wtr. PB 2704

Comp. 4 1/2 mcf gpd

J. G. McGEHEE