

Map No. KANSAS Sec. 19 Twp. 21 R. 2


Well No. 1- Trustee Farm
Lisher & Lauck et al Company

NORTH

A blank 10x10 grid with 'WEST' on the left and 'EAST' on the right. The grid is composed of 10 columns and 10 rows. The word 'WEST' is written vertically on the left side, and 'EAST' is written vertically on the right side. A small circle is drawn in the 6th column from the left and the 3rd row from the bottom.

SOUTH

Location _____

Drilling Remarks

Rig Up _____

Drilling Remarks

RECORD

Cased _____ in. _____ ft.

Sand _____

Gas _____

Oil _____

Total Depth_____

PRODUCTION

1st 24 hrs. Nat. _____

1st 24 hrs. after shot_____


Gas _____ cu. ft. _____

Dry Hole_____

Abandoned _____

Map No. **KANSAS** Sec. 19 Twp. 27 R. 2^E
 Well No. 1-Trustee Farm
Fisher & Lauck et al Company

NORTH

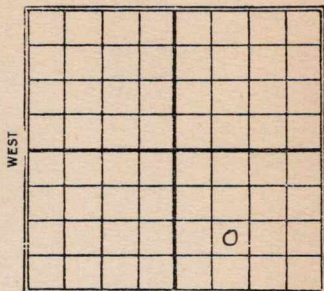

Ft. from N. Line

990 Ft. from S. Line

Ft. from E. Line

990 Ft. from W. Line

SOUTH

1929

Date	REPORT
<u>10/30</u>	<u>Spud</u>
<u>11/6</u>	<u>Drly 700'</u>
<u>11/13</u>	<u>" 1430</u>
<u>11/20</u>	<u>" 1735</u>
<u>11/27</u>	<u>" 2520</u>
<u>12/4</u>	<u>29 Chat 2927 TD 2932</u> <u>show oil - UK 6"</u>
<u>12/11</u>	<u>Chat 2927-38</u> <u>T.D. 2938</u> <u>swab 122 bbl oil</u> <u>and 5 " water</u> <u>Pump 44⁶ gravity</u>
<u>1932</u>	<u>OWDD</u>
<u>3/22</u>	<u>Base line 3183</u> <u>Pay 3235-44</u> <u>T.D. 3244</u> <u>Pump 25 bbls per hour</u> <u>Comp.</u>

Sealgwick
 Map No. **KANSAS** Sec. 19 Twp. 27 R. 24

Well No. 1 Trustee

Fisher & Launch & Co. Company

Contractor

SECTION PLAT

.....Ft. from N. Line

990 Ft. from S. Line

.....Ft. from E. Line

990 Ft. from W. Line

FIRST REPORTS

Location.....

Rig up.....

Drilling and Remarks:

Spud

RECORD

Cased.....in.,ft.

Sand.....

Gas.....

Oil.....

Total Depth.....

PRODUCTION

1st 24 hrs. Nat.....

1st 24 hrs. after shot.....

Gas.....Cu. Ft.

Dry Hole.....

Abandoned.....

Date

OCT 30 1929

192

S. J. LEWIS Scout

Map No. **KANSAS** Sec. 19 Twp. 27 R. 2E

Well No. 1 Trustee

Fisher-Launch & Co. Company

Contractor

SECTION PLAT

..... Ft. from N. Line

990 Ft. from S. Line

..... Ft. from E. Line

990 Ft. from W. Line

0

COMPLETED

Location.....

Rig up.....

Drilling and Remarks:

Chas 2927 38

Swat 812288 h oil

" 5" water

44.6 Gravity

RECORD

Cased..... in., ft.

Sand.....

Gas.....

Oil.....

Total Depth 2988

PRODUCTION

1st 24 hrs. Nat.....

1st 24 hrs. after shot.....

Gas..... Cu. Ft.

Dry Hole.....

Abandoned.....

Date

DEC 11 1929

192.....

S. J. LEWIS Scout

Seagwick

E

12 KANSAS Map No. Sec. 19 Twp. 27 R. 2

Well No. 1 Trustee
Fisher & Lauer Company

Contractor

FIRST REPORTS
and
COMPLETE

SECTION PLAT

		OWN	
		0	

Ft. from N. Line

990 Ft. from S. Line

Ft. from E. Line

990 Ft. from W. Line

Location

Rig up

Drilling and Remarks:

Base Line 3183

Pump 25 bbls
Per Hour.

RECORD

Cased in., ft.

Sand Pay 3235-3244

Gas

Oil

Total Depth 3244

PRODUCTION

1st 24 hrs. Nat.

1st 24 hrs. after shot

Gas Cu. Ft.

Dry Hole

Abandoned

Date

MAR 22 1932

19

CHAS. L. SHERWOOD

Scout