Form 51—5M—10-26—Mid-West

Greenwood

Map No. KS Sec. 4 Twp. 23 R. 13

Well No. 2 Smithson Farm

Gore & Skelly Oil Company

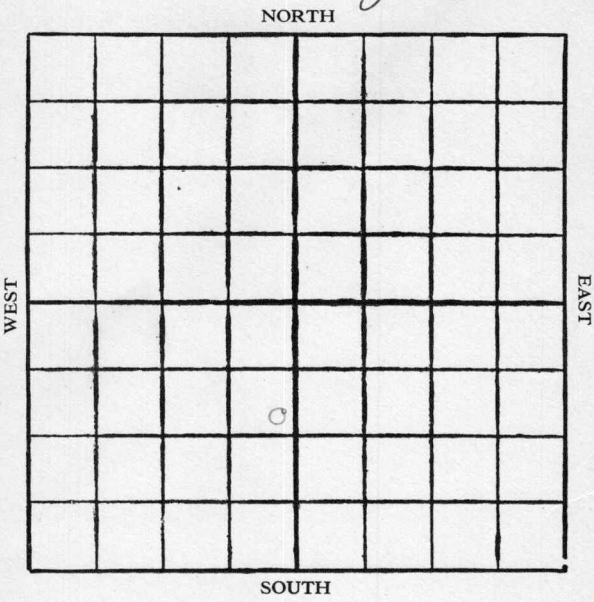

Location	Rig Up
Drilling Remarks	Drilling Remarks
RECORD	PRODUCTION
Cased ..... in. ..... ft.	1st 24 hrs. Nat.
Sand	1st 24 hrs. after shot
Gas	Gas ..... cu. ft.
Oil	Dry Hole
Total Depth	Abandoned

Form 252A—5M—11-25—20913 Greenwood

Map No. Kans Sec. 4 Twp. 23 R. 13

Well No. 2 - Smithurn Farm

Gore & Skelly Oil Company

1120 Ft. from N. Line

..... Ft. from S. Line

200 Ft. from E. Line

..... Ft. from W. Line

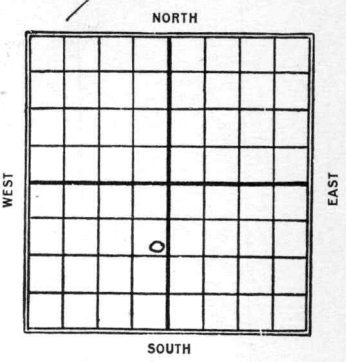

1926

Date	REPORT
11/11	Spudding
11/17	Drlg 680'
11/23	" 900
12/8	Dry sand 1637-60'
	Drlg 1675'
12/15	Top lime 1771'—1781'
	1500 ft fluid in hole
12/22	same
12/30	—
1927	
1/6	—
1/13	—
1/19	—
1/26	—
2/3	—
2/10	—
2/17	—
2/24	—
3/2	Dry sand 1637-60
	Top lime 1771-1781
	T.D. 1788
	40/10 bbls

Form 26—1M Bks.—3-23—11959. Sherwood

17 KANSAS

Map No._____ Sec. 4 Twp. 23 R. 13

Well No. 2 Mathurn

506 E Shelly Oil Company

_____ Contractor

SECTION PLAT

1120 Ft. from N. Line

_____ Ft. from S. Line

200 Ft. from E. Line

_____ Ft. from W. Line

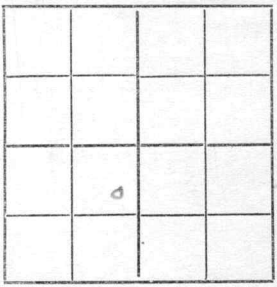

FIRST REPORTS

Location _____

Rig up _____

Drilling and Remarks:

Spudding

RECORD

Cased _____ in., _____ ft.

Sand _____

Gas _____

Oil _____

Total Depth _____

PRODUCTION

1st 24 hrs. Nat. _____

1st 24 hrs. after shot _____

Gas _____ Cu. Ft.

Dry Hole _____

Abandoned _____

Date

NOV 11 1926

_____ 192____.

CHAS. L. SHERWOOD

_____ Scout

Form 26—1M Bks.—3-23—11959. Sherwood

Map No. 17 KANSAS Sec. 4 Twp. 23 R. 13

Well No. 2 McClure

Gore & O'Kelly Company

Contractor

COMPLETED

SECTION PLAT

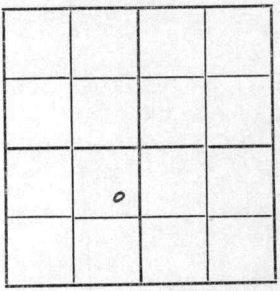

1120 Ft. from N. Line

Ft. from S. Line

200 Ft. from E. Line

Ft. from W. Line

Location

Rig up

Drilling and Remarks:

Dry Hole 1637-60

Lap Lime 1771-1781

TD 1788

4½ 10 Bbs.

RECORD

Cased in., ft.

Sand

Gas

Oil

Total Depth

PRODUCTION

1st 24 hrs. Nat.

1st 24 hrs. after shot

Gas Cu. Ft.

Dry Hole

Abandoned

Date

MAR 2 1927

192

CHAS. L. SHERWOOD

Scout