

Form 51-5M-4-27-27423

Map No. KANSAS Sec. 4 Twp. 23 R. 13
Well No. 39 Smithurn Farm
Gore & Speley Company

NORTH

WEST

EAST

SOUTH

Location

Drilling Remarks

Rig Up_____

Drilling Remarks

RECORD

Cased _____ in. _____ ft.

Sand

Gas

Oil

Total Depth-----

PRODUCTION

1st 24 hrs. Nat. _____

1st 24 hrs. after shot_____

Gas ----- cu. ft.

Dry Hole

Abandoned


Map No. KANSAS Sec. 4 Twp. 23 R. 13
Well No. 35 Antburn Farm
Gore & Skelly Company

.....Ft. from N. Line

250 Ft. from S. Line

1320 Ft. from E. Line

.....Ft. from W. Line

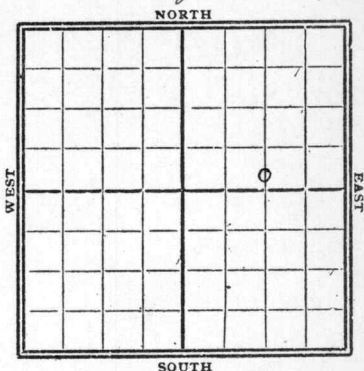

1928

Date

REPORT

10/10	Location
10/17	Rig up
10/24	Spdy 200'
10/31	Wrlg 800'
11/7	
11/14	show oil 1614-19
	Top line 1692'
	1st break 1707-27'
	good show oil to shoot
11/21	sand 1707-27'
	sand 1614-19 show
	Top line 1692'
	shot 40 gts
	10 bbls oil
	Comp TD 1727'

S. M. Woods

K17 KANSAS

MAP NO. _____ SEC. 4 TWP. 23 R. 13WELL NO. 3 AnthonyDory & Skelly COMPANY

CONTRACTOR

FIRST REPORTS

_____ FT. FROM N. LINE

250 FT. FROM S. LINE1370 FT. FROM E. LINE

_____ FT. FROM W. LINE

SECTION PLAT

LOCATION ✓

RIG UP _____

DRILLING AND REMARKS:

RECORD

CASED _____ IN. _____ FT.

SAND _____

GAS _____

OIL _____

TOTAL DEPTH _____

PRODUCTION

1ST 24 HRS. NAT. _____

1ST 24 HRS. AFTER SHOT _____

GAS _____ Cu. Ft.

DRY HOLE _____

ABANDONED _____

DATE

OCT 10 1928

CHAS. L. SHERWOOD

192

SCOUT

K17 KANSAS


MAP No. _____ SEC. 4 TWP. 23 R. 13WELL No. 3 In the wayGore & Kelly

COMPANY _____

CONTRACTOR _____

COMPLETED

SECTION PLAT

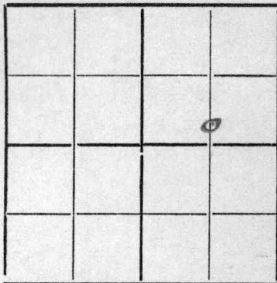

_____ FT. FROM N. LINE

250 FT. FROM S. LINE1320 FT. FROM E. LINE

_____ FT. FROM W. LINE

LOCATION _____

RIG UP _____

DRILLING AND REMARKS:

Sand 1614-19' Show
Top line 1692'
40 / 10 Bbs.

RECORD

CASED _____ IN. _____ FT.

SAND 1707-27

GAS _____

OIL _____

TOTAL DEPTH 1727

PRODUCTION

1ST 24 HRS. NAT. _____

1ST 24 HRS. AFTER SHOT _____

GAS _____ Cu. Ft.

DRY HOLE _____

ABANDONED _____

DATE

NOV 21 1928

CHAS. L. SHERWOOD

192

SCOUT