

Map No. 19 Sec. 27 Twp. 2E

Well No. 1-1000 (Sowkup) Farm

Shawver & Derby Company

NORTH

WEST

EAST

SOUTH

OWDD

Location _____

Drilling Remarks _____

Rig Up _____

Drilling Remarks _____

RECORD

Cased _____ in. _____ ft.

Sand _____

Gas _____

Oil _____

Total Depth _____

PRODUCTION

1st 24 hrs. Nat. _____

1st 24 hrs. after shot _____

Gas _____ cu. ft.

Dry Hole _____

Abandoned _____

Map No. _____ Sec. 19 Twp. 27 R. 2^E

Well No. 1- Saupap Farm _____


~~Seigel Bros~~ Company
Shawver & Derby NORTH

587 Ft. from N. Line

_____ Ft. from S. Line

_____ Ft. from E. Line

826 Ft. from W. Line

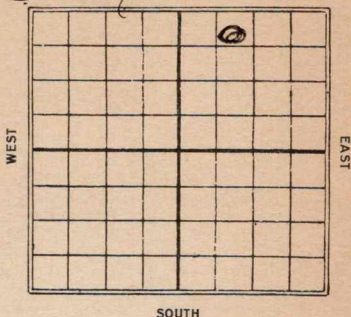

Date	REPORT
1930	
9/3	Reg
9/10	Reg up
9/17	Spud 403'
9/24	Dreg 930'
10/1	" 1585'
10/8	" 1785'
10/15	" 2170'
10/22	" 2770'
10/29	Top Chat 2975'
	T.D. 2978 = 2500' oil
11/5	S.D. 2978' No test
11/12	
11/19	Chat 2975-87
	T.D. 2987
	Swab 800 gal oil
	Comp.
1931	OWDD
11/4	Top Chat 2975'
	Old T.D. 2987
	Ru. to deeper
11/10	Dreg 3017'
	(over)

11/18- Base line 3211
drlg 3245'

11/24- Top sand 3261
Show oil 3262'

12/2- T.D. 3269
Rng tubing

12/9- Sand 3261-69
T.D. 3269

Made 500 bbl oil
Comp.

Map No. 12 **KANSAS** Sec. 19 Twp. 27 R. 2E

Well No. 1 Soukup

Seigel Bros. Company

Contractor

SECTION PLAT

587 Ft. from N. Line

_____ Ft. from S. Line

_____ Ft. from E. Line

826 Ft. from W. Line

FIRST REPORTS

Location _____

Rig up _____

Drilling and Remarks:

Rig

RECORD

Cased _____ in., _____ ft.

Sand _____

Gas _____

Oil _____

Total Depth _____

PRODUCTION

1st 24 hrs. Nat. _____

1st 24 hrs. after shot _____

Gas _____ Cu. Ft.

Dry Hole _____

Abandoned _____

Date

SEP 3 1930

19

S. J. LEWIS

Scout

Map No. KANSAS Sec. 19 Twp. 27 R. 2E

Well No. 1 Bonaparte

Seigel Bros. Company

Contractor

SECTION PLAT

587 Ft. from N. Line

..... Ft. from S. Line

..... Ft. from E. Line

826 Ft. from W. Line

COMPLETED

		0	

Location.....

Rig up.....

Drilling and Remarks:

RECORD

Cased..... in., ft.

Sand 2975 - 87

Gas.....

Oil.....

Total Depth 2987

PRODUCTION

1st 24 hrs. Nat.....

1st 24 hrs. after shot.....

Gas..... Cu. Ft.

Dry Hole.....

Abandoned.....

Date

NOV 19 1930

S. J. LEWIS Scout

Map No. KANSAS Sec. 19 Twp. 27 R. 2

Well No. 1 1000 up

Special Nos _____ Company

..... Contractor

FIRST REPORTS

587 Ft. from N. Line

.....Ft. from S. Line

Ft. from E. Line

876 Ft. from W. Line

OWD

SECTION PLAT

		0	

Location.....

Rig up.....

Drilling and Remarks:

Ripping up to
Deepen

RECORD

Cased 1 in., 0 ft.

Sand Top Chat 2975

Gas _____

Oil.....

Total Depth.....2987.....

PRODUCTION

1st 24 hrs. Nat.....

1st 24 hrs. after shot.....

Gas.....Cu. Ft.

Dry Hole.....

Abandoned.....

Date _____

NOV 4 1931 CHAS. L. SHERWOOD

192.....Scout

12 **KANSAS** Map No. Sec. 19 Twp. 27 R. 2^E

Well No. 1 *Bankup*

Shawver & Derby Company

Contractor

CORRECTION

587 Ft. from N. Line

Ft. from S. Line

Ft. from E. Line

876 Ft. from W. Line

SECTION PLAT

		0	

Location

Rig up

Drilling and Remarks:

*Prev Carried as
Seigel Bros.
Chg to above.*

RECORD

Cased in, ft.

Sand

Gas

Oil

Total Depth

PRODUCTION

1st 24 hrs. Nat.

1st 24 hrs. after shot

Gas Cu. Ft.

Dry Hole

Abandoned

Date

NOV 10 1931

CHAS. L. SHERWOOD

192

Scout

Seagwick

Map No. **KANSAS** Sec. 19 Twp. 27 R. 2 ^EWell No. 1 Sourcup
Shawver & Durby Company

Contractor

COMPLETED**SECTION PLAT**

		0	

587 Ft. from N. Line

Ft. from S. Line

Ft. from E. Line

876 Ft. from W. Line

Location

Rig up

Drilling and Remarks:

500 Bbs.

RECORD

Cased 3 in., 3 ft.

Sand 3261-3269

Gas

Oil

Total Depth 3269

PRODUCTION

1st 24 hrs. Nat.

1st 24 hrs. after shot

Gas Cu. Ft.

Dry Hole

Abandoned

Date

DEC 9 1931 CHAS. L. SHERWOOD

192

Scout