


Map No. Kansas Sec. 4 Twp. 23 R. 13
 Well No. 11 Inthurn Farm
Gore et al Company

NORTH

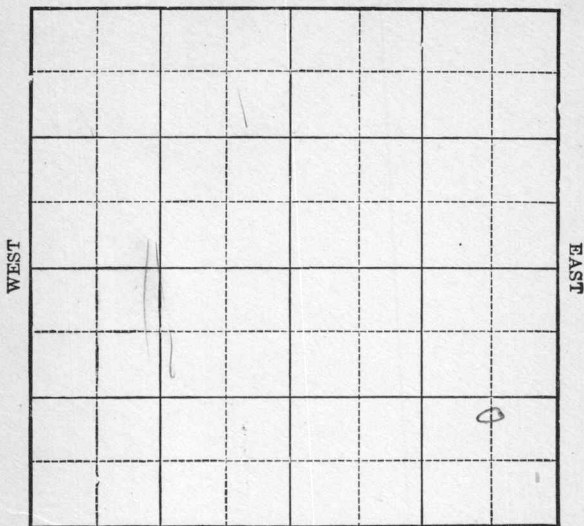

SOUTH

Location _____

Drilling Remarks _____

Rig Up _____

Drilling Remarks _____

RECORD

Cased _____ in. _____ ft.

Sand _____

Gas _____

Oil _____

Total Depth _____

PRODUCTION

1st 24 hrs. Nat. _____

1st 24 hrs. after shot _____

Gas _____ cu. ft.

Dry Hole _____

Abandoned _____

Greenwood

Map No. 5AN Sec. 4 Twp. 23 R. 13

Well No. 11 Imbhorn Farm


Gore et al Company

Ft. from N. Line

1120 Ft. from S. Line

660 Ft. from E. Line

Ft. from W. Line

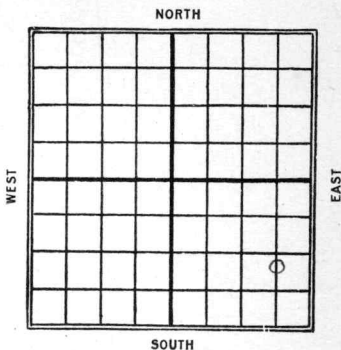

1926

Date _____

REPORT

7/21 Drlg 1000'
7/28 sand 1578-1614
120/30 bbls. T.D. 1614

K17 KANSAS

Map No. _____ Sec. 4 Twp. 23 R. 13Well No. 11 In the

_____ Company

_____ Contractor

FIRST REPORTS

_____ Ft. from N. Line

1120 _____ Ft. from S. Line660 _____ Ft. from E. Line

_____ Ft. from W. Line

SECTION PLAT

			0

Location _____

Rig up _____

Drilling and Remarks:

Only 1000'

RECORD

Cased _____ in., _____ ft.

Sand _____

Gas _____

Oil _____

Total Depth _____

PRODUCTION

1st 24 hrs. Nat. _____

1st 24 hrs. after shot _____

Gas _____ Cu. Ft.

Dry Hole _____

Abandoned _____

Date

JUL 21 1926

192

CHAS. L. SHERWOOD

Scout

K17 KANSAS

Map No. Sec. 4 Twp. R. 13

Well No. 11

Company

Contractor

COMPLETED

SECTION PLAT

Ft. from N. Line
Ft. from S. Line
Ft. from E. Line
Ft. from W. Line

Location
Rig up
Drilling and Remarks:

RECORD
Cased in, ft.
Sand 1578-1614
Gas
Oil
Total Depth 1614
PRODUCTION
1st 24 hrs. Nat.
1st 24 hrs. after shot
Gas
Cu. Ft.
Dry Hole
Abandoned

Date
JUL 28 1926
CHAS. L. SHERWOOD
Scout