


*Greenwood*Map No. *Kansas* Sec. *4* Twp. *23* R. *13E*Well No. *16 Smith* Farm
Gore et al Company

Ft. from N. Line

1120 Ft. from S. Line*785* Ft. from E. Line

Ft. from W. Line

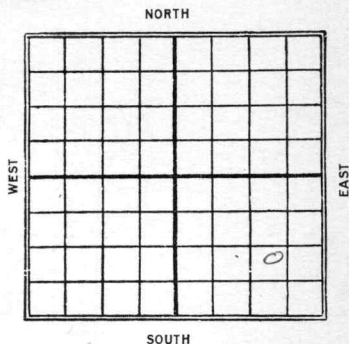


Date

REPORT

*1927**1/12 Drilling 900**1/19 same**1/26 6"-1496**2/3 same**2/10 sand 1584-1614**80/40 bbls**J.D. 1614*

Map No. 15 Sec. 4 Twp. 23 R. 13E
 Well No. 16 - Inthurn Farm
Gore et al Company

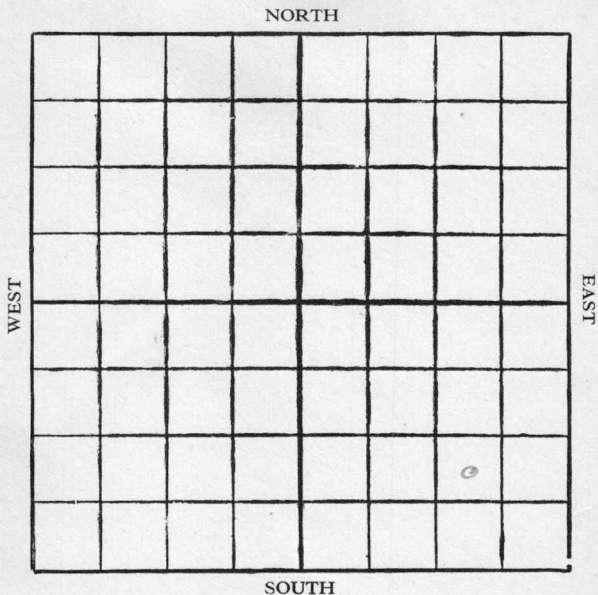

Location

Drilling Remarks

Rig Up.....

Drilling Remarks

RECORD

Cased.....in.ft.

Sand

Gas

Oil

Total Depth.....

PRODUCTION

1st 24 hrs. Nat.....

1st 24 hrs. after shot.....

Gas..... cu. ft.

Dry Hole.....

Abandoned

Greenwood

17 KANSAS

Map No. _____ Sec. 4 Twp. 22 R. 12

Well No. 16 in church Farm

Sore et al Company

NORTH

		1120' from S.L.			
		785' " E.L.			
		FIRST REPORTS			

SOUTH

Location

Rig up

Drilling and Remarks:

RECORD

Cased _____ in., _____ ft.

Sand

Gas

Oil

Total Depth _____

PRODUCTION

1st 24 hrs. Nat.

1st 24 hrs. after shot.....

Gas	Cu. Ft.
-----	---------

Dry Hole

Abandoned

Date
JAN 12 1927

CHAS. L. SHERWOOD

192

Scout

17 KANSAS
 Map No. _____ Sec. 4 Twp. 23 R. 13
 Well No. 16 In the
 Sole of Hh _____ Company
 _____ Contractor

COMPLETED

SECTION PLAT

_____ Ft. from N. Line
 1120 _____ Ft. from S. Line
 785 _____ Ft. from E. Line
 _____ Ft. from W. Line

			0

Location _____

Rig up _____

Drilling and Remarks:

867 40 lbs.

RECORD

Cased _____ in., _____ ft.

Sand 1584-1614 _____

Gas _____

Oil _____

Total Depth 1614 _____

PRODUCTION

1st 24 hrs. Nat. _____

1st 24 hrs. after shot _____

Gas _____ Cu. Ft.

Dry Hole _____

Abandoned _____

Date

FEB 10 1927

192

CHAS. L. SHERWOOD

Scout