Form 51 5M 7-22 9573

Map No. 15 Sec. 31 Twp. 23 R. 10

Well No. 10 - Mulvadall Farm

Mid-Kansas Company

NORTH

WEST

EAST

SOUTH

Location _____

Drilling Remarks:

Rig up _____

Drilling Remarks:

RECORD

Cased _____ in. _____ ft.

Sand _____

Gas _____

Oil _____

Total Depth _____

PRODUCTION

1st 24 hrs Nat. _____

1st 24 hrs. after shot _____

Gas _____ cu. ft.

Dry Hole _____

Abandoned _____

Form 252A 5M 2-24 15129

Map No. K Sec. 31 Twp. 23 R. 10

Well No. 10 - Martindale Farm


Mid-Kans. Company

200 Ft. from N. Line

Ft. from S. Line

660 Ft. from E. Line

Ft. from W. Line

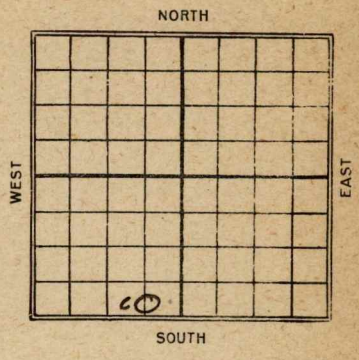

Date	REPORT
6/18	Rig
7/16	Shot.
8/16	Top 2253 - Fdl 2307
	Bottom Sand 2361
	T.D. 2363
	240/300 Bbls

Form 26—1M Bks.—3-23—11959.

(16) KANSAS

Map No._____ Sec. 31 Twp. 23 R. 10

Well No. 10 Martindale

Mid - Kans. Company

_____ Contractor

FIRST REPORT


_____Ft. from N. Line

300 Ft. from S. Line

660 Ft. from E. Line

_____Ft. from W. Line

SECTION PLAT

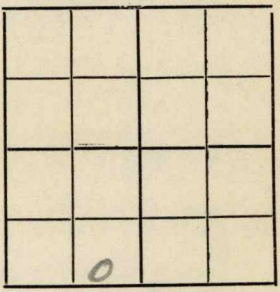

Location _____

Rig up _____

Drilling and Remarks:

R.O.G.

RECORD

Cased_____in., _____ ft.

Sand _____

Gas _____

Oil _____

Total Depth _____

PRODUCTION

1st 24 hrs. Nat. _____

1st 24 hrs. after shot _____

Gas _____ Cu. Ft.

Dry Hole _____

Abandoned _____

Date

JUN 18 1924

M. A. BENEAR

_____192____. _____Scout

Form 26—1M Bks.—3-23—11959.

Map No. 76 KANSAS Sec. 31 Twp. 23 R. 10


Well No. 10 Martindale

Mid-Kansas Company

Contractor

COMPLETED

SECTION PLAT

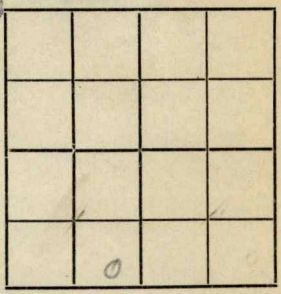

Ft. from N. Line

200 Ft. from S. Line

660 Ft. from E. Line

Ft. from W. Line

Location

Rig up

Drilling and Remarks:

Top S. 2253-70, 2307

Bottom S. 2361

TD. 2363

240/300

RECORD

Cased in., ft.

Sand

Gas

Oil

Total Depth

PRODUCTION

1st 24 hrs. Nat.

1st 24 hrs. after shot

Gas Cu. Ft.

Dry Hole

Abandoned

Date

AUG 26 1924

192

M. A. BENEAR

Scout