


Section 35 Township 25 Range 10E

Well No. #1 Doles

Company Gulf Coast Western Oil

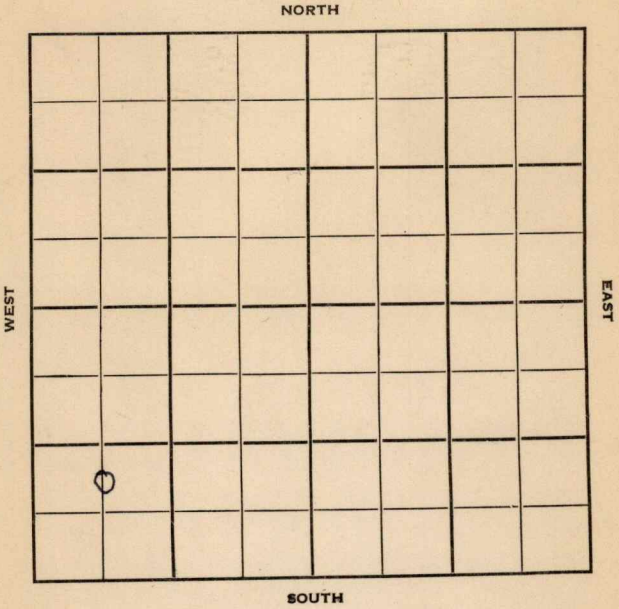

Sec. 35 Twp. 25 R. 10E

Well No. #1 Doles Farm

Gulf Coast Western Oil Company

McGinnis Contractor

Eureka Pool


           Ft. from N. Line

990' Ft. from S. Line

           Ft. from E. Line

660' Ft. from W. Line

C N L SW SW

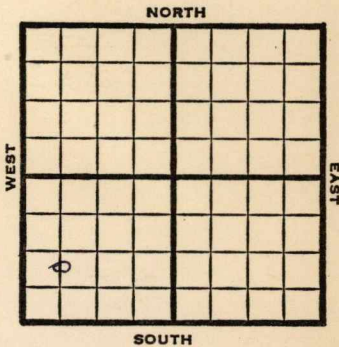

1950

**Elev. ?**

REPORT

6/21

Spud 6-16-50  
10" @ 100'  
Drlg. 900'

7/5

10" @ 100'  
**Miss 1991'**  
4" @ 1994'  
TD 2004'  
Comp. 25 BOPD

**COMPLETED**

Map No. \_\_\_\_\_ Sec. 35 Twp. 25 R. 10E

Well No. 1 Doles

Gulf Coast Western Oil Company

McGinnis Contractor

C N L SW SW

SECTION PLAT

\_\_\_\_\_ Ft. from N. Line

990 Ft. from S. Line

\_\_\_\_\_ Ft. from E. Line

660 Ft. from W. Line



Greenwood County

Location \_\_\_\_\_

Rig up \_\_\_\_\_

Drilling and Remarks:

Spud 6-16-50

10" @ 100

drlg. 900

RECORD

Cased \_\_\_\_\_ in., \_\_\_\_\_ ft.

Sand \_\_\_\_\_

Gas \_\_\_\_\_

Oil \_\_\_\_\_

Total Depth \_\_\_\_\_

PRODUCTION

1st 24 hrs. Nat. \_\_\_\_\_

1st 24 hrs. after shot \_\_\_\_\_

Gas \_\_\_\_\_ Cu. Ft.

Dry Hole \_\_\_\_\_

Abandoned \_\_\_\_\_

Date

JUN 21 1950 19

J. E. TYRA Scout

Map No. \_\_\_\_\_ Sec. 35 Twp. 25 R. 10E

Well No. 1 Doles

Gulf Coast Western Oil Company

Contractor

C N L SW SW

SECTION PLAT

\_\_\_\_\_ Ft. from N. Line

990 Ft. from S. Line

\_\_\_\_\_ Ft. from E. Line

660 Ft. from W. Line

COMPLETE			
o			

Greenwood County

Location \_\_\_\_\_

Rig up \_\_\_\_\_

Drilling and Remarks:

10" @ 100

Miss. 1991

4" @ 1994

TD 2004

Comp. 25 bopd

RECORD

Cased \_\_\_\_\_ in., \_\_\_\_\_ ft.

Sand \_\_\_\_\_

Gas \_\_\_\_\_

Oil \_\_\_\_\_

Total Depth 2004

PRODUCTION

1st 24 hrs. Nat. \_\_\_\_\_

1st 24 hrs. after shot \_\_\_\_\_

Gas \_\_\_\_\_ Cu. Ft.

Dry Hole \_\_\_\_\_

Abandoned \_\_\_\_\_

Date

JUL 5 1950 19

J. E. TYRA Scout