

# KANSAS

FORM 51 IOM 12-46 PETROL

Section 4 Township 23 Range 13-E

Well No. 25 Inthurn


Company Shaffer & Howell

Virgil Pool

NORTH

WEST

EAST

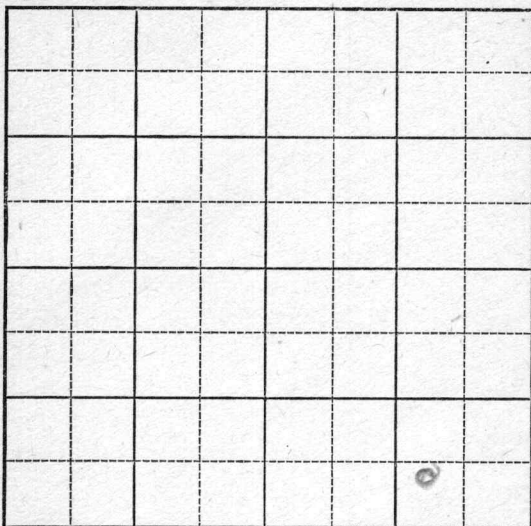

SOUTH

Sec. 4 Twp. 23 R. 13-EWell No. #25 Inthurn FarmShaffer & Howell Company

Virgil Pool


Ft. from N. Line

550 Ft. from S. Line

990 Ft. from E. Line

Ft. from W. Line

C W L SE SE

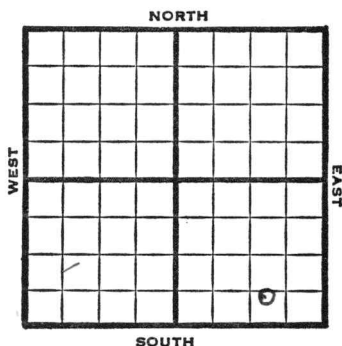

1947

## REPORT

7/2 Machine

7/8 "

7/16 13" @ 635'  
10" @ 950'  
Drlg. 1060'7/22 8" : 1485  
Bart 1575  
TD 1613  
40 qts 1600  
CO

7/29 "

8/6 "

8/13 Bart 1575'  
8" @ 1485'  
48 qts.  
Pump 3 oil / 4 w. Potl.  
Gr. 38  
T.D. 1613'  
Complete

COMPLETED

Map No. \_\_\_\_\_ Sec. 4 Twp. 23 R. 13E

Well No. 25 Inthurn

Shaffer & Howell

Company

**FIRST REPORT**

Contractor

C W L SE SE

**SECTION PLAT**

\_\_\_\_\_ Ft. from N. Line

550 Ft. from S. Line

990 Ft. from E. Line

\_\_\_\_\_ Ft. from W. Line

|  |  |  |  |
|--|--|--|--|
|  |  |  |  |
|  |  |  |  |
|  |  |  |  |
|  |  |  |  |

Greenwood County

Location \_\_\_\_\_

Rig up \_\_\_\_\_

Drilling and Remarks:

Machine

**RECORD**

Cased \_\_\_\_\_ in., \_\_\_\_\_ ft.

Sand \_\_\_\_\_

Gas \_\_\_\_\_

Oil \_\_\_\_\_

Total Depth \_\_\_\_\_

**PRODUCTION**

1st 24 hrs. Nat. \_\_\_\_\_

1st 24 hrs. after shot \_\_\_\_\_

Gas \_\_\_\_\_ Cu. F

Dry Hole \_\_\_\_\_

Abandoned \_\_\_\_\_

Date

JUL 2 1947 19

S. J. LEWIS

