


Section 35 Township 25 Range 10E

Well No. #1 Davis

Company Gulf Coast Western Oil

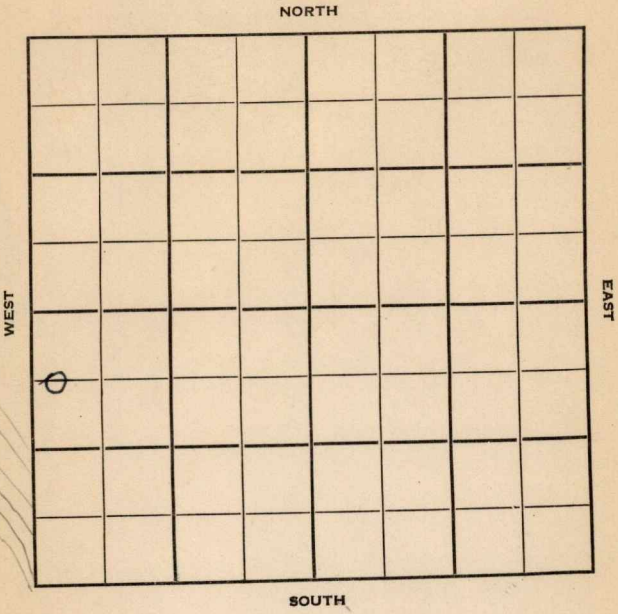

Sec. 35 Twp. 25 R. 10E

Well No. #1 Davis Farm

Gulf Coast Western Oil Company


Miscellaneous (Sunflower Drlg. ^C Contr.)

660' Ft. from N. Line

_____ Ft. from S. Line

_____ Ft. from E. Line

200' Ft. from W. Line

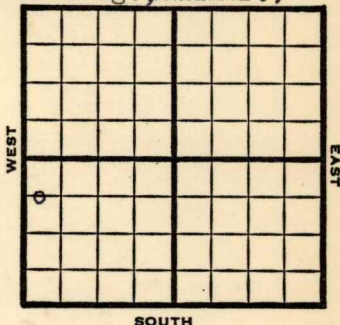

C W L NW SW

REPORT

1949

12/28 8" @ 93'
Miss 1967'
TD 1971'
5" @ 1971'

1950

1/11 TD 1989'
8"@ 93'
5"@ 1971'
PP 28 BOPD
Miss 1967'
Comp

COMPLETED

Map No. _____ Sec. 35 Twp. 25 R. 10E

Well No. 1 Davis

Gulf Coast & Western Oil Company

Sunflower Drlg. Contractor

C W L NW SW

FIRST REPORT
SECTION PLAT

660 Ft. from N. Line

_____ Ft. from S. Line

_____ Ft. from E. Line

200 Ft. from W. Line

Greenwood County

Location _____

Rig up _____

Drilling and Remarks:

8" @ 93

Miss. 1967

TD 1971

5" @ 1971

RECORD

Cased _____ in., _____ ft.

Sand _____

Gas _____

Oil _____

Total Depth _____

PRODUCTION

1st 24 hrs. Nat. _____

1st 24 hrs. after shot _____

Gas _____ Cu. Ft.

Dry Hole _____

Abandoned _____

Date

DEC 28 1949

19

S. J. LEWIS

Scout

Map No. _____ Sec. 35 Twp. 25 R. 10E

Well No. 1 Davis

Gulf Coast Western Oil Company

Contractor

C W L NW SW

SECTION PLAT

	COMPLETE			
o				

660 Ft. from N. Line

_____ Ft. from S. Line

_____ Ft. from E. Line

200 Ft. from W. Line

Greenwood County

RECORD

Location _____

Cased _____ in., _____ ft.

Rig up _____

Sand _____

Drilling and Remarks:

Gas _____

8" @ 93

Oil _____

5" @ 1971

Total Depth 1989

PP 28 BOPD

PRODUCTION

1st 24 hrs. Nat. _____

1st 24 hrs. after shot _____

Gas _____ Cu. Ft.

Dry Hole _____

Abandoned _____

Date

JAN 11 1950

J. E. TYRA

Scout