


Map No. 1 Sec. 35 Twp. 25 R. 10E
Well No. Bennett & Able Farm Greenwood
Company

NORTH

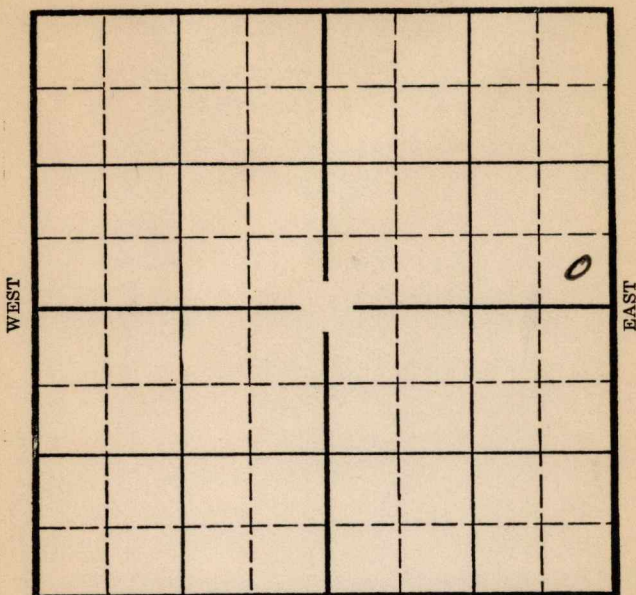

SOUTH

Location _____
Drilling Remarks _____

Rig Up _____
Drilling Remarks _____

RECORD

Cased _____ in. _____ ft.
Sand _____
Gas _____
Oil _____
Total Depth _____

PRODUCTION

1st 24 hrs. Nat. _____
1st 24 hrs. after shot _____
Gas _____ cu. ft. _____
Dry Hole _____
Abandoned _____

Map No. _____ Sec. 23 Twp. 23 R. 10
Well No. 1- Graham Farm _____
Bennett & Able Company _____

Ft. from N. Line

200 Ft. from S. Line

200 Ft. from E. Line

Ft. from W. Line

NORTH

WEST

EAST

SOUTH

Date _____

REPORT

8/28 dly 1600
9/6 Feb 1600
10/3
10/9 TL 1976
TJ 1985
1000 acid
25 Bbl.

COMPLETED

Map No. 16 Sec. 35 Twp. 25 R. 10EWell No. 1-Mabham
Bennett + Able Company

Contractor

FIRST REPORTS

SECTION PLAT

			0

Ft. from N. Line

300 Ft. from S. Line300 Ft. from E. Line

Ft. from W. Line

Location.....

Rig up.....

Drilling and Remarks:

1600

RECORD

Cased.....in.,ft.

Sand.....

Gas.....

Oil.....

Total Depth.....

PRODUCTION

1st 24 hrs. Nat.....

1st 24 hrs. after shot.....

Gas.....Cu. Ft.

Dry Hole.....

Abandoned.....

Date

8-28-35 192

ORVAL MANNSCHRECK

Scout

KANSAS

Map No. 16 Sec. 35 Twp. 25 R. 10 EWell No. 1- KrahhamBennett + Able CompanyCOMPLETED Contractor

SECTION PLAT

			0

Ft. from N. Line

330 Ft. from S. Line300 Ft. from E. Line

Ft. from W. Line

Location

Rig up

Drilling and Remarks:

1000 and25 bbls

RECORD

Cased _____ in., _____ ft.

~~Sand~~ TL 1976

Gas _____

Oil _____

Total Depth 1985

PRODUCTION

1st 24 hrs. Nat. _____

1st 24 hrs. after shot _____

Gas _____ Cu. Ft.

Dry Hole _____

Abandoned _____

Date

10-9-35 192. _____ Scout

ORVAL MANNSCHRECK