


Section 4 Township 23 Range 13EWell No. 27 ImthurnCompany Shaffer & Howell

Miscellaneous

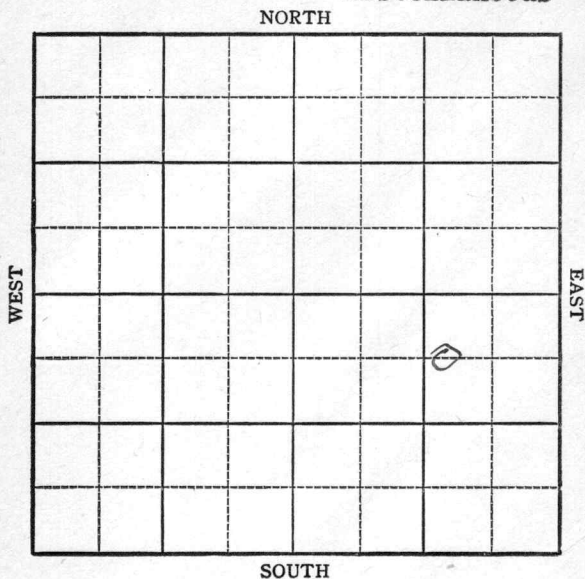

KANSAS

Greenwood



Sec. 4 Twp. 23 R. 13E

Well No. #27 Imthurn Farm

Shaffer & Howell

Company

Miscellaneous


550 Ft. from N. Line

_____ Ft. from S. Line

1050 Ft. from E. Line

_____ Ft. from W. Line

C W L NE SE

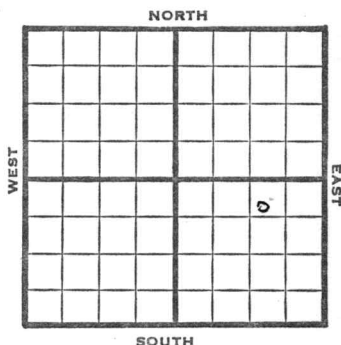

1948

REPORT

9/8 13" @ 664'
Drlg. 795'

9/14 10" @ 978'
8" @ 1295'
Drlg. 1435'

9/21 Bart 1610'
5" @ 1610'

9/29 TD 1636'
TD 1636'
Bart 1610'
5"@ 1610'
30 qts to 1614-26
Pump 6 oil Pot
38° Gr.
Comp

COMPLETED

Map No. 17 Sec. 4 Twp. 23 R. 13E

Well No. 27 Imthurn

Shaffer & Howell Company

COMPLETE Contractor

C W L N E S E

SECTION PLAT

			o

550 Ft. from N. Line

_____ Ft. from S. Line

1050 Ft. from E. Line

_____ Ft. from W. Line

Greenwood County

Location _____

Rig up _____

Drilling and Remarks:

Bar 7/16/10

5"-11" @ 1610

309 to 1614-26

Pung 6 oil Rod

38-24

RECORD

Cased _____ in., _____ ft.

Sand _____

Gas _____

Oil ☒ _____

Total Depth 1636

PRODUCTION

1st 24 hrs. Nat. _____

1st 24 hrs. after shot _____

Gas _____ Cu. Ft.

Dry Hole _____

Abandoned _____

Date

SEP 29 1948 19

S. J. LEWIS Scout