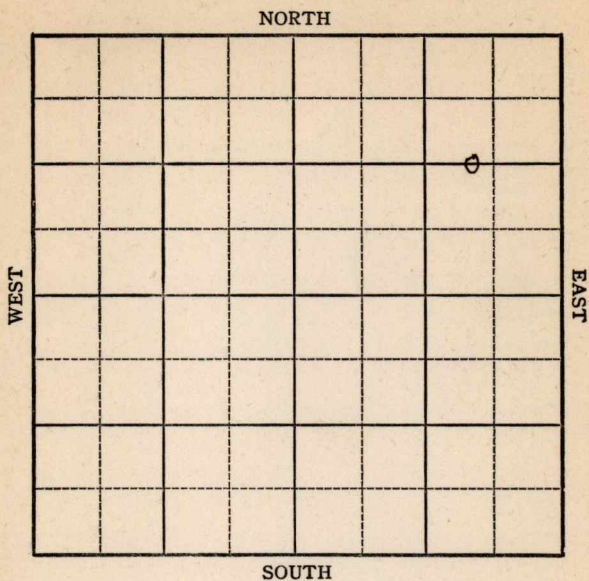



Section 36 Township 25 Range 9EWell No. #30Company Ind. Terr. Ill. Oil Co.

Map No. _____ Sec. 36 Twp. 25 R. 9Well No. 30 Farm _____J.T.C. Company _____1320 Ft. from N. Line

_____ Ft. from S. Line

810 Ft. from E. Line

_____ Ft. from W. Line

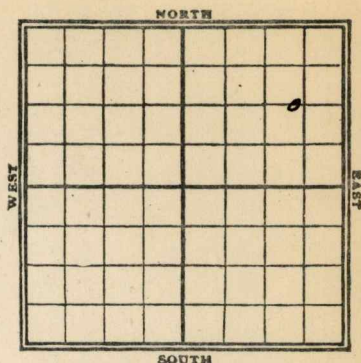

Date	REPORT
9/29	Rgn up
10/6	500'
10/14	1300'
10/20	1989-2020- 190/budgeted
10/27	6.0 show for your
	well
11/3	C.O.
11/15	1989-2020- shot
	190 gts / 75 lbs.

Map No. 51 Sec. 36 Twp. 25 R. 9Well No. 30

Company

Contractor

SECTION PLAT

			0

1320 Ft. from N. Line

Ft. from S. Line

810 Ft. from E. Line

Ft. from W. Line

Location

Rig up

Drilling and Remarks:

Rgn up

RECORD

Cased _____ in., _____ ft.

Sand _____

Gas _____

Oil _____

Total Depth _____

PRODUCTION

1st 24 hrs. Nat. _____

1st 24 hrs. after shot _____

Gas _____ Cu. Ft.

Dry Hole _____

Abandoned _____

Date

9/27 1920GW 9 Scout

Map No. 51 Sec. 36 Twp. 25 R. 9Well No. 30 Farm

Company

NORTH

WEST

EAST

SOUTH

Location.....

Rig up.....

Drilling and Remarks:

RECORD

Cased.....in. Ft.

Sand

Gas

Oil

Total Depth.....

PRODUCTION

1st 24 hrs. Nat.....

1st 24 hrs. after shot.....

Gas.....Cu. Ft..

Dry Hole.....

Abandoned

Date

Scout.