

Section 11 Township 11 Range 17 W

Well No. # 1 Slimmer

Company Derby Oil

NORTH

15

WEST

EAST

0

SOUTH

Sec. 11 Twp. 11 R. 17W

Well No. #1 Slimmer Farm _____

Derby Oil Company _____

Rocket Drlg. Contractor _____

Turkville Pool


_____ Ft. from N. Line

330 Ft. from S. Line

_____ Ft. from E. Line

330 Ft. from W. Line

SW SW SE

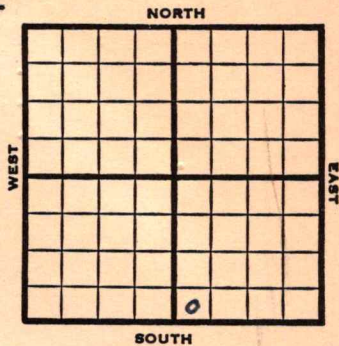

1953

Elev. 1803'

REPORT

5/27

M I R

6/3

8" @ 109'

Drlg 1120'

6/10

DST 3092-99 1 hr, 760' ocs w,
800#

DST 3107-12 1 hr, 75' M 940#

DST 3155-76 1 hr, 125' HO&OCM 200'
gas 1300#

Drlg 3317'

6/24

No report

7/22

NR

8/5

Spud 5-30-53

Oil Well

TD 3362

8" @ 1009

DST 3692-99, opn 1 hrs., rec. 760' ocs w,
800#

DST 3107-12, opn 1 hr., rec. 75' mud
& sw, 940#

DST 3155-76, opn 1 hr., rec. 125' ho &
ocm, 200' gas, 1300#

Heeb 2965, Lans 3007

DST 3234-62, opn 1 hr., rec. 10' mud,
0#

Cong 3270, Simp 3310, Simp dol 3335,

Arb 3358

DST 3358-62, opn 1 hr., rec. 950' sw,
1060#

OVER

(Information Brought Forward)

1953

8/5

TD 3362

5" @ 3361

CO to 3326

8/3211-13, 2 gwph, some oil, 500A

PB 3196, 28/3163-70, 4 go 1 hrs.,

500A, 2 boph, 1500A, S/2 boph, 10/3165-

70, 2000A, 3 boph

P/82 bo 6% wtr.

P/63 bo 7⁰ wtr.,

P/51 bo 7% wtr.

Comp. 40 bopd 6% wtr.

COMPLETED

County Ellis State Kansas

Sec. 11 (Blk. 11) (Sur. 17W) Map No. 11

Operator Derby Oil

Well No. 1 Farm Slimmer

Elev. 1803 Location SW SW SE

330 Ft. From S Line SE

330 Ft. From W Line Quarter

1st. Report

Completion AUG 5 1953

Remarks Turkville Pool

Rocket Drlg. - Contr.

Spudding Date 5-30-53

Drlg. Data Oil well TD 3362

8" @ 1009 DST 3692-99 open 1 hr.

Rec. 760' ocs w 800# DST 3107-12

open 1 hr. Rec. 75' mud & sw 940#

DST 3155-76 open 1 hr. Rec. 125' ho &

ocm 200' gas 1300# Heeb. 2965

Lans. 3007 DST 3234-62 open 1 hr.

Rec. 10' mud 0# Cong. 3270 Simp. 3310

Simp. dol. 3335 Arb. 3358 DST 3358-62

open 1 hr. Rec. 950' sw 1060# TD 3362

5" @ 3361 CO to 3326 8/ 3211-13

2 gwph some oil 500 A FB 3196

28/ 3163-70 4 go 1 hr. 500 A 2 boph

1500 A S/ 2 boph 10/ 3165-70 2000 A

3 boph P/ 82 bo 6% wtr.

J. G. McGEHEE

Drlg. Data

P/ 63 bo 7% wtr. P/ 51 bo 7% wtr.

Comp. 40 bopd

6% wtr.

Scout Cards
Land Small Map
Land Wall Map
Tracing
France Map
Pierce Map
MISC.

Handwritten initials

AUG 11 1963