

KANSAS

FORM 51 5M 10-41 PETROL


Chase



Section 15 Township 20 Range 7-E

Well No. #1 Drummond

Company Aladdin Petr. et al
~~O. J. Connell et al~~

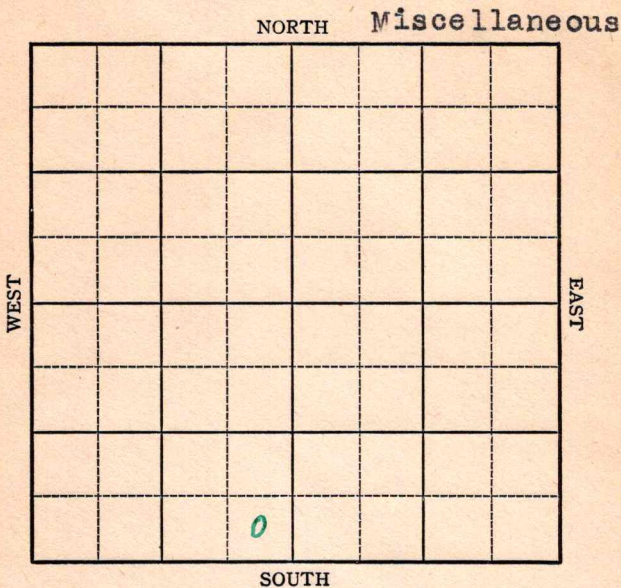

1942

2/4

Lans. 1515'

K.C. 1722'

Arb. 2133'

Basal sand 2182'

Granite 2325'

T.D. 2409'

No shows.

ABANDONED

Chase

KANSAS

Map No. 22 Sec. 15 Twp. 20 R. 7EWell No. 1 DrummondO. J. Connell et al. CompanyFIRST REPORT Contractor

SE SW

SECTION PLAT

 Ft. from N. Line330 Ft. from S. Line330 Ft. from E. Line Ft. from W. Line

MISCELLANEOUSLocation Rig up

Drilling and Remarks:

Moving in Cable
ToolsRECORDCased in., ft.Sand Gas Oil Total Depth PRODUCTION1st 24 hrs. Nat. 1st 24 hrs. after shot Gas Cu. Ft.Dry Hole Abandoned

Date

DEC 3 1941 19S. J. LEWIS Scout

Map No. 22 Sec. 15 Twp. 20 R. 7EWell No. 1 DrumondAladdin Petroleum et al. Company

CORRECTION

Contractor

SE SW

SECTION PLAT

 Ft. from N. Line330 Ft. from S. Line330 Ft. from E. Line Ft. from W. Line

MISCELLANEOUS

Location Rig up

Drilling and Remarks:

Reported as

O. J. Connell,
et al.

RECORD

Cased in., ft.Sand Gas Oil Total Depth

PRODUCTION

1st 24 hrs. Nat. 1st 24 hrs. after shot Gas Cu. Ft.Dry Hole Abandoned

Date

JAN 7 1942 19

S. J. LEWIS Scout

Map No. 22 Sec. 15 Twp. 20 R. 7EWell No. 1 DrummondAladdin Petroleum etal CompanyABANDONED

Contractor

SE SW

SECTION PLAT

_____ Ft. from N. Line

330 Ft. from S. Line330 Ft. from E. Line

_____ Ft. from W. Line

MISCELLANEOUS

Location _____

Rig up _____

Drilling and Remarks:

*have 1515**KC 1722**Cr 42133**Basal Sol 2174**Granite 2025.**No hours*

RECORD

Cased _____ in., _____ ft.

Sand _____

Gas _____

Oil _____

Total Depth 2409

PRODUCTION

1st 24 hrs. Nat. _____

1st 24 hrs. after shot _____

Gas _____ Cu. Ft.

Dry Hole _____

Abandoned _____

Date

FEB 4 1942 19

S. J. LEWIS Scout