


Map No. **KANSAS** Sec. 19 Twp. 27 R. 2E

Well No. 11 Trustee Farm
Fisher & Lauck Company

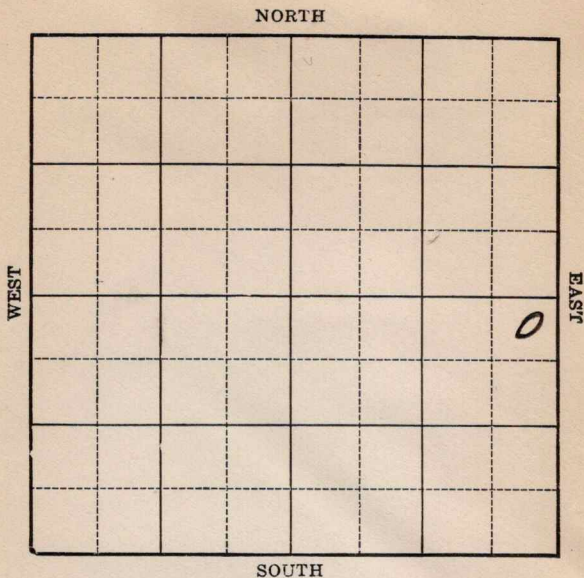

Location _____

Drilling Remarks _____

RECORD

Cased _____ in. _____ ft.

Sand _____

Gas _____

Oil _____

Total Depth _____

Rig Up _____

Drilling Remarks _____

PRODUCTION

1st 24 hrs. Nat. _____

1st 24 hrs. after shot _____

Gas _____ cu. ft. _____

Dry Hole _____


Abandoned _____

Hedgwick

Map No. Sec. 19 Twp. 27 R. 2 E

Well No. 11 Trustee Farm
Fisher & Lauck Company

NORTH

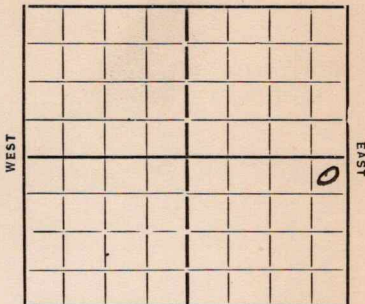

330 Ft. from N. Line

 Ft. from S. Line

330 Ft. from E. Line

 Ft. from W. Line

Date 12/14

REPORT

10/31 Rig
11/8 R & L
11/15 Dlg 520
11/27 " 1465
11/28 " 1800
12/6 K.C. 2495 A.O. 2629-34
12/13
12/19 Chat 2948 T1) 2958
60 Bbls.

COMPLETED

KANSAS

Map No. 12 Sec. 19 Twp. 27 R. 2EWell No. 11-Trustee
Trisher + Lanck Company

Contractor

FIRST REPORTS

SECTION PLAT

330 Ft. from N. Line

_____ Ft. from S. Line

330 Ft. from E. Line

_____ Ft. from W. Line

			0

Location _____

Rig up _____

Drilling and Remarks:

Rig

RECORD

Cased _____ in., _____ ft.

Sand _____

Gas _____

Oil _____

Total Depth _____

PRODUCTION

1st 24 hrs. Nat. _____

1st 24 hrs. after shot _____

Gas _____ Cu. Ft.

Dry Hole _____

Abandoned _____

Date

10-31-34 19

ORVAL MANNSCHRECK

Scout

KANSAS

Map No. 12 Sec. 19 Twp. 27 R. 2 EWell No. 11-Trustee
Fisher & Lank Company

Contractor

COMPLETED

SECTION PLAT

330 Ft. from N. Line

Ft. from S. Line

330 Ft. from E. Line

Ft. from W. Line

			0

Location

Rig up

Drilling and Remarks:

60 fth

RECORD

Cased in, ft.

Sand Chat 2948

Gas

Oil

Total Depth 2958

PRODUCTION

1st 24 hrs. Nat.

1st 24 hrs. after shot

Gas Cu. Ft.

Dry Hole

Abandoned

Date

12-19-34 192 ORVAL MANNSCHRECK Scout