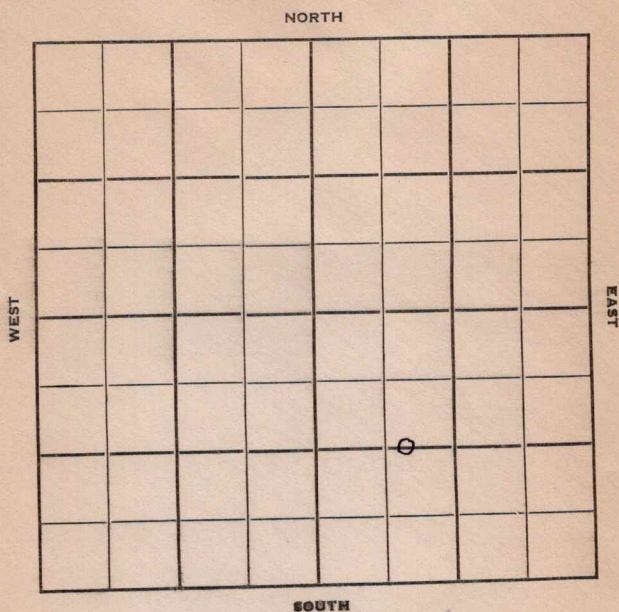


Section 19 Township 27 Range 2EWell No. #13 TrusteeCompany Abe Steckel

Sedgwick

KANSAS

Sec. 19 Twp. 27 R. 2E ✓

Well No. #13 Trustee Farm

Abe Steckel Company

Uhl - Contr. Contractor

Eastborough Pool


1215' Ft. from N. Line

_____ Ft. from S. Line

_____ Ft. from E. Line

990' Ft. from W. Line

C E L $W\frac{1}{2}$ SE

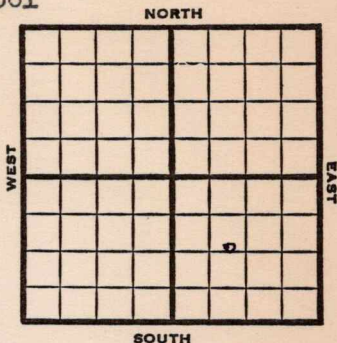

1951

Elev. 1348'

REPORT

8/8

RUR

10/17

Oil well TD 2953

8" @ 105

Br. lime 2491

Miss. 2940

TD 2953

5" @ 2944

28/ 2946-53

Comp. 25 BOPD

COMPLETED

County **Sedgwick** State **Kansas**

Sec. 19 (Blk. Twp.) 27 (Sur. Rge.) 2E Map No.

Operator Abe Steckel

Well No. **13** Farm **Trustee**

Elev.	Location	C E L W $\frac{1}{2}$ SE
-------	----------	--------------------------

FIRST REPORT

1215 Ft. From N Line SE

990 Ft. From W Line Quarter

1st. Report AUG 8 1951

Completion

Remarks

Uh1 - Contr.

Spudding Date _____

Drbg. Data

R U R

J. E. TYRA

County Sedgwick State KansasSec. 19 (Blk.
Twp.) 27 (Sur.
Rge.) 2E Map No. _____Operator Abe SteckelWell No. 13 Farm TrusteeElev. 1348 Location C E L W $\frac{1}{2}$ SE1215 Ft. From N Line SE990 Ft. From W Line Quarter1st. ReportCompletion OCT 17 1951Remarks Eastborough PoolSpudding DateDrlg. Data Oil well TD 29538" @ 105 Br. lime 2491 Miss. 2940TD 2953 5" @ 2944 28/ 2946-53Comp. 25 bopd