

Sedgwick
Form 51-5M-1-30-38840

O. W. D. D
19 Twp. 27 R. 2^E

Map No. **KANSAS** Sec. 29 Twp. 27 R. 27

Well No. 4 - McKelvey-Kelley Farm

Company

WEST

EAST

SOUTH

Drilling Remarks

Drilling Remarks

Cased _____ in. _____ ft.

Sand

Gas

Oil_____

Total Depth.....

1st 24 hrs. Nat.-----

1st 24 hrs. after shot_____

Gas _____ cu. ft. _____


Dry Hole_____

Abandoned.....

O.W.D.D

Map No. KANSAS Sec. 19 Twp. 27 R. 2E ✓
 Well No. 4 - Wheeler - Kelley Farm
Magnolia Company

NORTH

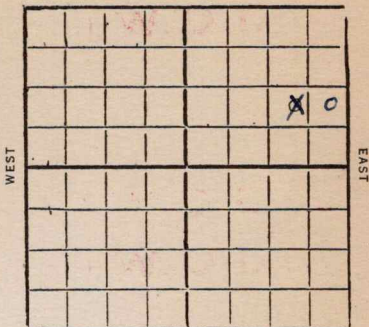

Ft. from N. Line

990

Ft. from S. Line

995

Ft. from E. Line

330

822

Ft. from W. Line

1931

NE SE NE

SOUTH

Date

REPORT

Elev

3/4 Reg
 3/11 Stand
 3/18 dry 980
 3/25 " 1635'
 4/11 Top Kans Cy line 2490
dry 2530'
 4/8 8" - 2730
dry 2780'
 4/15 Chat 2943-58
T.D. 2958
700 bbl oil
Comp

1951

O.W.D.D For SWD

6/13

KC 2490' TD 2958' 7" @ 2942 was KC prod. DD 3353'

Schl tops: memor 32231, Viola 3245'

Simp 3270', Arb. 3338',

5" @ 3342 DD 3358 500 A

S/ 1 GOPH plus 15 BWPH DD 3534' TD

2000 A

Comp. for SWD

FIRST REPORT

ABANDONED

Map No. Scotsgwick Sec. 19 Twp. 27 R. 25

Well No. 4 Wheeler

Magnolia P & S Company

Contractor

SECTION PLAT

			0

_____ Ft. from N. Line

995 Ft. from S. Line

822 Ft. from E. Line

_____ Ft. from W. Line

FIRST REPORTS

Location _____

Rig up _____

Drilling and Remarks:

Rig

RECORD

Cased _____ in., _____ ft.

Sand _____

Gas _____

Oil _____

Total Depth _____

PRODUCTION

1st 24 hrs. Nat. _____

1st 24 hrs. after shot _____

Gas _____ Cu. Ft.

Dry Hole _____

Abandoned _____

Date

MAR 4 1931

S. J. LEWIS

Scout

Seegwicks

12 KANSAS

Map No. Sec. 19 Twp. 27 R. 2 E

Well No. 4 Wheeler

Magnolia Pet Co. Company

Contractor

COMPLETE

SECTION PLAT

			o

Ft. from N. Line

995 Ft. from S. Line

800 Ft. from E. Line

Ft. from W. Line

Location

Rig up

Drilling and Remarks:

700 Bbls.

RECORD

Cased in., ft.

2943-2958

Sand

Gas

Oil

Total Depth 2958

PRODUCTION

1st 24 hrs. Nat.

1st 24 hrs. after shot

Gas Cu. Ft.

Dry Hole

Abandoned

Date

APR 15 1931

192

CHAS. L. SHERWOOD

Scout

J. E. TYRA