

FORM 51 IOM 12-46 PETROL

Section 15 Township 11 Range 18-W

Well No. 1 Henderson

Company Berry & Shay *Shade & Berry*

Burnett Pool NORTH

WEST

EAST

SOUTH

0

KANSAS

O.W.W.O. ✓

Ellis

Sec. 15 Twp. 11 R. 18W

Well No. #1 Henderson Farm

~~Berry & Shay~~
Burnett Pool

Shade & Berry Company

 Ft. from N. Line


330

 Ft. from S. Line

330

 Ft. from E. Line

 Ft. from W. Line

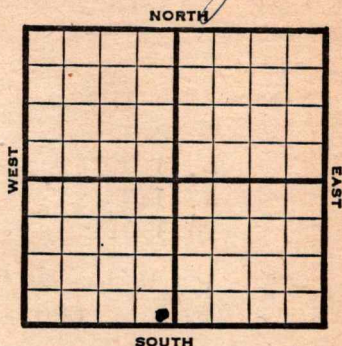

SE SE SW

1947

Elev. 1951' REPORT

10/8

Drlg. 650'

10/15

8" @ 1235'
Drlg. 2535'

10/22

Topeka 2901'
Lansing 3190'
BKC 3417'
Conglomerate 3440'
Simpson 3473'
Arbuckle 3498'
TD 3499½
6" @ 3499'
RUST

10/29

"

11/5

TD 3501'
1500' oil 1 hr.

11/12

"

11/19

"

11/25

"

12/3

Arbuckle 3498'
6" @ 3499'
Echo Pot 3000
Gr. 360
Total Depth 3501'

COMPLETED

OVER

1956

O.W.W.O.

7-11 6" @ 3499
To PB to Lans.
L. 3190'; C. 3440'; S. 3473';
A. 3498';
TD 3501'

7-25 PB 3484; 24/3339-45
P/ 100 BOPD / trace wtr.
TD 3501'

COMPLETED

Map No. _____ Sec. 15 Twp. 11 R. 18W

Well No. 1 Henderson


Berry & Shay Company

FIRST REPORT

Contractor

SE SW

SECTION PLAT

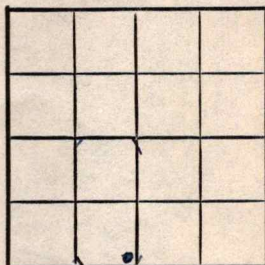

330 Ft. from N. Line

330 Ft. from S. Line

330 Ft. from E. Line

_____ Ft. from W. Line

Ellis County

Location _____

Rig up _____

Drilling and Remarks:

drlg. 650'

RECORD

Cased _____ in., _____ ft.

Sand _____

Gas _____

Oil _____

Total Depth _____

PRODUCTION

1st 24 hrs. Nat. _____

1st 24 hrs. after shot _____

Gas _____ Cu. Ft.

Dry Hole _____

Abandoned _____

Date

OCT 8 1947

19

S. J. LEWIS

Scout

Map No. 71 Sec. 15 Twp. 11 R. 18W

Well No. 1 Henderson

Berry & Shay Company

COMPLETE

Contractor

SE SW


E. 1. 1951
SECTION PLAT

 Ft. from N. Line

330 Ft. from S. Line

330 Ft. from E. Line

 Ft. from W. Line

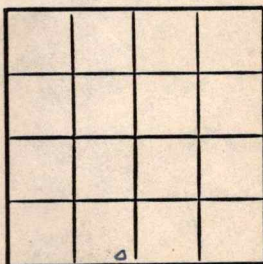

Ellis County

Location

Rig up

Drilling and Remarks:

Per 8498

6" C 8498

Ech 12 8498000

86-9-51

RECORD

Cased in., ft.

Sand

Gas

Oil

Total Depth 2521

PRODUCTION

1st 24 hrs. Nat.

1st 24 hrs. after shot

Gas Cu. Ft.

Dry Hole

Abandoned

Date

DEC 3 1947 19

S. J. LEWIS

Scout

O.W.W.O.

FORM 513 SUNRAY

County Ellis Elev. 1951
 Sec. 15 Twp. 11 Rge. 18W
 Company Shade & Berry
 Farm Name Henderson No. 1

Co.

Lse.

No.

Sec.

T.

R.

TOPS DEPTH LOG DATUM

Loc. in Sec.

Anh. SE SE SW

Tp. OWWO























3190

3440

3473

3498

3501

Geol.

Contr.

Pool

SW Burnett

FIRST REPORT

JUL 11 56

0

Date Comm.

6" @ 3499 to PB to Lans.

3301 E S III

G. R.

County Ellis Elev. 1251
 Sec. 15 Twp. 11 Rge. 18W
 Company Shade & Berry
 Farm Name Henderson No. 1

TOPS	DEPTH	LOG	DATUM	Loc. in Sec.
Anb.				SE SE SW
Tp.				<u>OWHO</u>
H.				
Tr.				
Dg.				
Bl.				
L.	3190			Geol.
K.C.				Contr.
B.K.C.				
Ce.	3110			
C.				
M.				Pool
M.				SW Barnett
K.				
Mz.				
Me.				
V.				
S.	3173			COMPLETE
S.				
A.	3198			JUL 2 5 1956
R.				
Pe.				
G.				
T.D.	3501			

Date Comm.

6" @ 31.99 to PB to Lans. JUL 18 '56

JUL 25 '56 PB 3484 24/3339-45

no test nat. (2) P. 100 Bopd
+ trace wtr.