


M. W. Purson
Form 51-5M-1-30-38840
Map No. **KANSAS** Sec. 25 Twp. 19 R. 2w
Well No. 1-Prehail Farm
Woody Creek & Sinclair Company

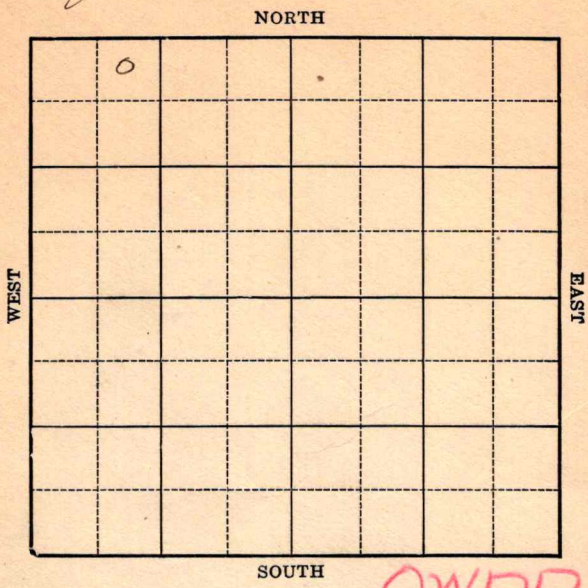

Location _____
Drilling Remarks _____

Rig Up _____
Drilling Remarks _____

RECORD


Cased _____ in. _____ ft.
Sand _____
Gas _____
Oil _____
Total Depth _____

PRODUCTION

1st 24 hrs. Nat. _____
1st 24 hrs. after shot _____
Gas _____ cu. ft.
Dry Hole _____
Abandoned _____

Map No. **KANSAS** Sec. 25 Twp. 19 R. 2^wWell No. 1- Krehvil FarmWolf Creek & Sinclair Company

NORTH

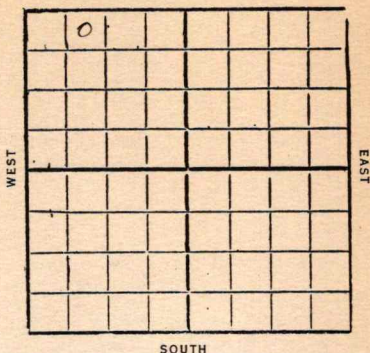330 Ft. from N. Line

Ft. from S. Line

Ft. from E. Line

990 Ft. from W. Line1931

SOUTH

Date

REPORT

3/4 Loc
3/11
3/18
3/25 ROS
4/11
4/18 Bldg rig
4/15 Run up
4/22
4/29 Spdy
5/6 Drlg 1050'
5/13 " 1970'
5/20 SD 1970'
5/27 SD 2145' for csg
6/3
6/10 Drlg 2205'
6/17 " 2350'
6/24 " 2770'
7/11 Top chat 2912 2917
show gas
Run 6"- 2912
7/15 Drlg 2948'
(over)

7/8 - Top Chat 2917 SZM
gas 2919 - 6" -
1 1/2 M gas at 2928"

S.D. 2932'
7/22 - T.D. 2952' Chat
5 M gas and
est 200 bbls oil

7/29 - T.D. 2952
13/4 M gas and
(est) 200 bbl oil
shut in for pipe line

8/5 - T.D. 2955' Chat
shut in for pipe line

8/12 —

8/19 —

8/26 —

9/2 —

9/9 —

9/16 —

9/23 —

9/30 - 6" - 2919

Chat 2917-5.5

T.D. 2955

1,898,000 cu ft gas

Comp.

1932

7/13 -

OWDD


Old TD 2955

deepened to 2967

Est 25 to 30 bbls per hr

Map No. Kansas Sec. 25 Twp. 19 R. 2^WWell No. 1 - Krehbie Farm
Wolf Creek & Sinclair Company330 Ft. from N. Line Ft. from S. Line Ft. from E. Line990 Ft. from W. Line1932

NORTH

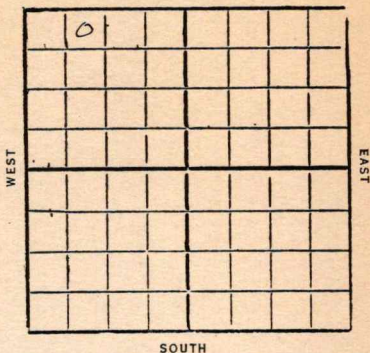

SOUTH

Date

REPORT

OWDD

7/20 Top Chat 2917
deepened to
TD 2967
Potential prod
220 bbl oil
Comp.

1933 OWDD

11/28 Well deepen

12/6 Reg 3000'

12/12 " 3125'

12/27 Base Line 3131

Top Viola 3395 5" at 3396

1/4 TD 3401- to acidize

1/11 will pump.

1/17 run tubing

1/24 T.D. 3402 1/2

Treated with 1000 gal acid

1/31 —

2/7 Viola 3395 TD 3402 1/2 1000

gal acid 414 Bbls.

COMPLETED

Map No. **KANSAS** Sec. 25 Twp. 19 R. 2W

Well No. 1 H E H 116 C

Holly Creek & Sinclair O & G Company

Contractor

SECTION PLAT

0			

330 Ft. from N. Line

_____ Ft. from S. Line

_____ Ft. from E. Line

990 Ft. from W. Line

FIRST REPORTS

Location ✓

Rig up _____

Drilling and Remarks:

RECORD

Cased _____ in., _____ ft.

Sand _____

Gas _____

Oil _____

Total Depth _____

PRODUCTION

1st 24 hrs. Nat. _____

1st 24 hrs. after shot _____

Gas _____ Cu. Ft.

Dry Hole _____

Abandoned _____

Date

MAR 4 1931

S. J. LEWIS

Scout

43

McPherson

Map No. **KANSAS** Sec. **25** Twp. **19** R. **2**^W

Well No. **1 Krehbie**

Waly Creek & Sinclair Company

Contractor

COMPLETED

SECTION PLAT

0			

330 Ft. from N. Line

Ft. from S. Line

Ft. from E. Line

990 Ft. from W. Line

Location

Rig up

Drilling and Remarks:

RECORD

Cased **6** in., **2919** ft.

Sand **Chas** **2917-55**

Gas

Oil

Total Depth **2955**

PRODUCTION

1st 24 hrs. Nat.

1st 24 hrs. after shot

Gas **1,898,000** Cu. Ft.

Dry Hole

Abandoned

Date

SEP 30 1931

192

CHAS. L. SHERWOOD

Scout

43 KANSAS

Map No. _____ Sec. 25 Twp. 19 R. 2

Well No. 1 Krehbier

Moyle Creek Oil Co. et al Company

Contractor

FIRST REPORTS

SECTION PLAT

330 Ft. from N. Line

_____ Ft. from S. Line

_____ Ft. from E. Line

990 Ft. from W. Line

0			

Location _____

Rig up _____

Drilling and Remarks:

Old T.D. 2955

D.D. to 2967

est 25 to 30 lbs

Per Hour.

RECORD

Cased _____ in., _____ ft.

Sand _____

Gas _____

Oil _____

Total Depth _____

PRODUCTION

1st 24 hrs. Nat. _____

1st 24 hrs. after shot _____

Gas _____ Cu. Ft.

Dry Hole _____

Abandoned _____

Date

JUL 13 1932

CHAS. L. SHERWOOD

192

Scout

43 **KANSAS** Sec. 25 Twp. 19 R. 2

Well No. 1 Krehbiel

Holy Creek Oil Co. & Co. Company

Contractor

COMPLETED

SECTION PLAT

330 Ft. from N. Line

Ft. from S. Line

Ft. from E. Line

990 Ft. from W. Line

0			

Location

Rig up

Drilling and Remarks:

Top Chat 2917'

Deepened To 2967

Potential Prod

220 Bbls.

RECORD

Cased in., ft.

Sand

Gas

Oil

Total Depth 2967

PRODUCTION

1st 24 hrs. Nat.

1st 24 hrs. after shot

Gas Cu. Ft.

Dry Hole

Abandoned

Date

JUL 20 1932

192

CHAS. L. SHERWOOD

Scout

Map No. 43 Sec. 25 Twp. 19 R. 2WWell No. 1-15 KrehbielWolfe Creek State Company

Contractor

SECTION PLAT

0			

FIRST REPORTS

330 Ft. from N. Line

Ft. from S. Line

Ft. from E. Line

990 Ft. from W. Line

Location

Rig up

Drilling and Remarks:

OTD 2967pulling tubing

RECORD

Cased.....in.,ft.

Sand.....

Gas.....

Oil.....

Total Depth.....

PRODUCTION

1st 24 hrs. Nat.....

1st 24 hrs. after shot.....

Gas.....Cu. Ft.

Dry Hole.....

Abandoned.....

Date

11-28-33 192 D. M. Mannedred Scout

Map No. 43 Sec. 25 Twp. 19 R. 2WWell No. 1-KriebelWolfe Creek Company

Contractor

COMPLETED

SECTION PLAT

0			

330 Ft. from N. Line

Ft. from S. Line

Ft. from E. Line

990 Ft. from W. Line

Location

Rig up

Drilling and Remarks:

1000 gal oil414 bbls

RECORD

Cased _____ in., _____ ft.

Sand Viola 3395

Gas _____

Oil _____

Total Depth 3402 1/2

PRODUCTION

1st 24 hrs. Nat. _____

1st 24 hrs. after shot _____

Gas _____ Cu. Ft.

Dry Hole _____

Abandoned _____

Date

2-7-34 192 O. Mammick Scout