DX 78-1

KINGMAN

KANSAS

Section 26 Township 29S Range 8W

Well No. #1 Duckworth

Company Petroleum, Inc.

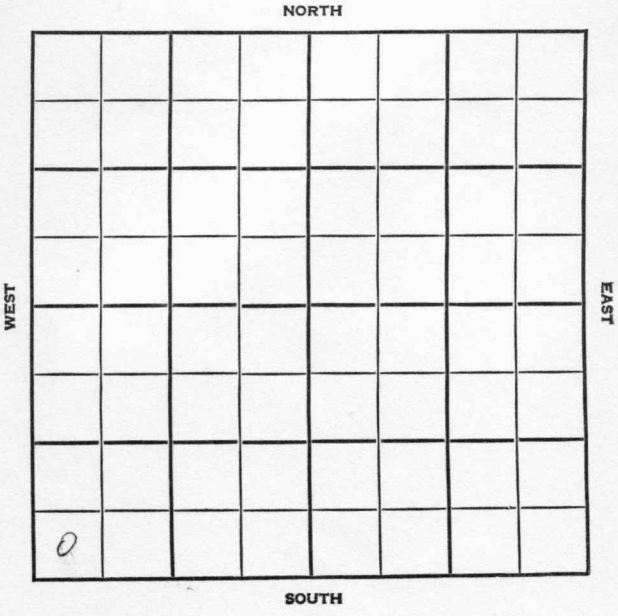

Kingman KANSAS

SEC.	TWP.	R.
26	29S	8W

WELL NO.

1 Duckworth FARM

COMPANY

Petroleum, Inc.

CONTRACTOR

Garvey rig #11

_____ FT. FROM N. LINE

_____ FT. FROM S. LINE

_____ FT. FROM E. LINE

_____ FT. FROM W. LINE

SW SW SW

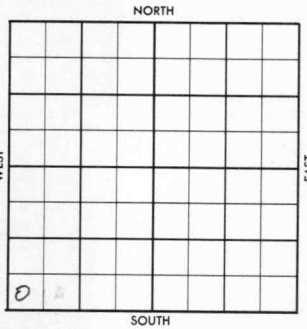

Magnolia FO

1956	ELEVATION 1610' REPORT
6-20	Comm. 6-16-56 8" @ 280 w/250 Drlg. 1341
7-3	DST 4209-30 op 1 hr., gas to surf. in 11 min, rec. 25' mud, ≠ 180' GCM ≠ 120' MW, BHP 1200/20". DST 4230-60 op 1 hr. rec. 290' GIP ≠ 90' GCM(spkd oil), 1050/20". DST 4260-4302 op 1 hr., rec. 20' mud, no BHP. D & A H. 3232', Tr. 3253', Dg. 3280', L. 3461', M. 4207', TD 4302', ABANDONED

FORM 513 SUNRAY

County Kingman Elev. 1610 Co.

Sec. 26 Twp. 29S Rge. 8W

Company Petroleum, Inc.

Farm Name Duckworth No. 1

TOPS	DEPTH	LOG	DATUM
Anh.			
Tp.			
H.	3232		
Tr.	3253		
Dg.	3280		
Bl.			
L.	3461		
K.C.			
B.K.C.			
Ce.			
C.			
M.	4207		
M.			
K.			
Mz.			
Mo.			
V.			
S.			
S.			
A			
R.			
P€.			
G.			
T.D.	4302		

Loc. in Sec. SW SW SW

Mag. - FO

Geol.

Contr. Garvey rig #11

Pool

ABANDONED

Lse.

No.

Sec.

T.

R.

Date Comm. 6-16-56

JUL 3 1956

8" 280 w/250; D 1341 JUN 27 '56 D 4062.

JUL 3 '56 DST 4209-30 1hr g to S. 11" ne 25' Md + 180' GCM (sso) + 120' MW BHP 1200/20 DST 4230-60 1hr ne 290' Fig + 90' GCM (SPKS oil) 1050/20 DST 4260-4302 1hr ne 20 Md no BHP

D&A

FORM 513 SUNRAY

County Kingman Elev.

Sec. 26 Twp. 29S Rge. 8W

Company Petroleum, Inc.

Farm Name Duckworth No. 1

TOPS	DEPTH	LOG	DATUM
Anh.			
T.P.			
H.			
Tr.			
Dg.			
B.L.			
L.			
K.C.			
B.K.C.			
Ce.			
C.			
M.			
M.			
K.			
Mr.			
Mo.			
V.			
S.			
S.			
A			
R.			
P€.			
G.			
T.D.			

Loc. in Sec. SW SW SW

Mag. - FO

Geol.

Contr. Garvey rig #11

Pool

FIRST REPORT

Date Comm. 6-16-56

JUN 20 '56

8" 280 w/250; D 1341

Co. Lse. No. Sec. T. R.