
FORM 51 O.W.W.O. Kingman KANSAS

Section 12 Township 29 Range 9 W

Well No. # 1 Tiesmeyer

Company ~~Stearns Pet.~~ Tenn. Gas Trans.

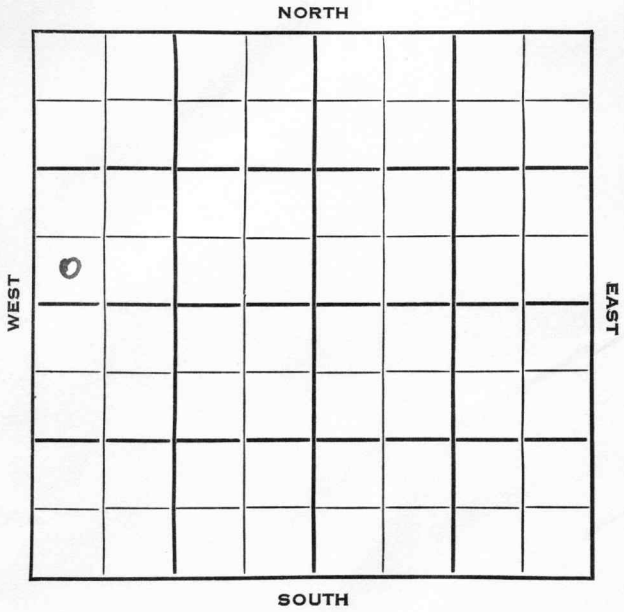

Kingman KANSAS

SEC.	TWP.	R.
12	29	9 W

WELL NO.

1 Tiesmeyer FARM
COMPANY

Stearns Pet.
CONTRACTOR


Wildcat

_____ Ft. from N. Line

330 Ft. from S. Line

_____ Ft. from E. Line

330 Ft. from W. Line

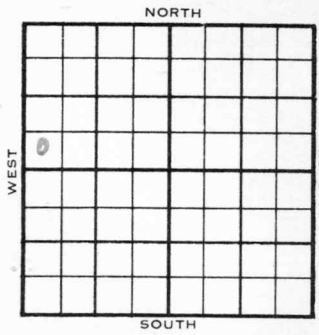

SW SW NW
Magnolia F/O and DHM

	ELEVATION	REPORT
1953	1710'	
11/18	RUR	
1954 1/13	Spud 11-19-53 D&A TD 4696' 8" @ 254' Br lime 3567', KC 3581' DST 3931-46', opn 1 hr., rec. 56' muddy sw, 1620# DST 3964-76', opn 1 hr., rec. 140' muddy sw, 1200# B KC 4020', Miss 4209' DST 4213-25', opn 1 hr., rec. 200' ocm, 1395# Kh 4317' DST 4485-4520', opn 1 hr., rec. 75' socm, 150# Viola 4517', Simp. 4584', Simp sd 4596' DST 4589-4601', opn ¼ hrs., rec. 2640' sw, 1645# Arb. 4676' TD 4696' 5" @ 4465 CO to 4480 24/4208-18, 500 mud acid S/10 bfph PB 4200	

DX-78

OVER

FORM 275 FOR SALE BY KANSAS BLUE PRINT CO.


County Kingman State Kansas

Sec. 12 (Blk. Twp.) 29 (Sur. Rge.) 9W Map No.

Operator Stearns Pet.

Well No. 1 Farm Tiesmeyer

Elev. 1710 Location SW SW NW

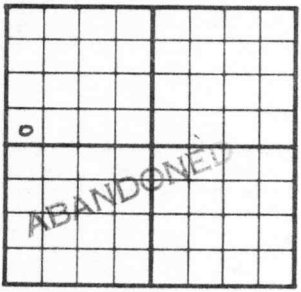

330 Ft. From S Line NW

330 Ft. From W Line Quarter

1st. Report

Completion JAN 13 1954

Remarks Wildcat

Spudding Date 11-19-53

Drlg. Data D & A TD 4696

8" @ 254 Br. lime 3567 KC 3581

DST 3931-46 open 1 hr. Rec. 56' muddy sw 1620# DST 3964-76 open 1 hr. Rec. 140' muddy sw 1200# B KC 4020

Miss. 4209 DST 4213-25 open 1 hr. Rec. 200' ocm 1395# Kh. 4317

DST 4485-4520 open 1 hr. Rec. 75' socm 150# Viola 4517 Simp. 4584 Simp. sd. 4596 DST 4589-4601 open ¼ hr. Rec. 2640' sw 1645# Arb. 4676 TD 4696

5" @ 4465 CO to 4480 24/ 4208-18 500 mud acid S/ 10 bfph PB 4200

9/ 4164-67 dry 11/ 3963-67 sw PB 3950 24/ 3925-30 10 gfph

J. G. McGEHEE

FORM 275 FOR SALE BY KANSAS BLUE PRINT CO.

County Kingman State Kansas

Sec. 12 (Blk. Twp.) 29 (Sur. Rge.) 9W Map No.

Operator Stearns Pet.

Well No. 1 Farm Tiesmeyer

Elev. Location SW SW NW



330 Ft. From S Line NW

330 Ft. From W Line Quarter

1st. Report NOV 18 1953

Completion

Remarks Magnolia farmout & DHM

Spudding Date

Drlg. Data Wildcat

RUR

J. G. McGEHEE

(Information BroughtForward)

1954
1/13 9/4164-67 dry
11/3963-67 sw
PB 3950
24/3925-30, 10 gfph
perf 3925-32
S/4 gwph
mud-acid
S/41 gwph dec. to 4 gwph 500A
250A
CO to 3940
19/3925-31, 1000A
S/22 bwph SSO 7 hrs.
FU 1700' wtr.
D&A

ABANDONED