


Map No. **KANSAS** Sec. 19 Twp. 27 R. 2EWell No. 10 Wheeler, Kelly, Shyne Farm
Magnolia Pit. Company

NORTH

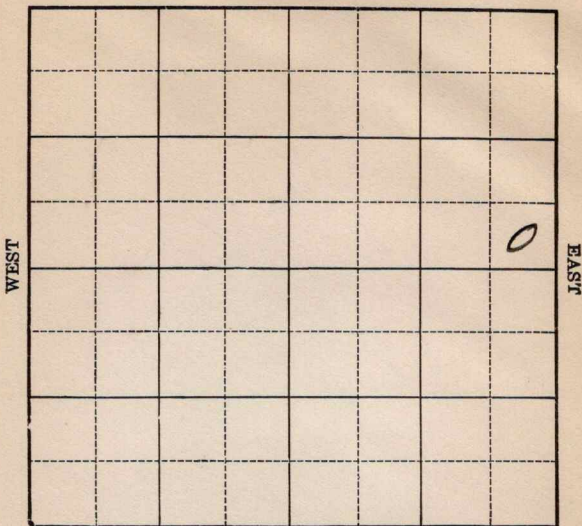

SOUTH

Location _____

Drilling Remarks _____

Rig Up _____

Drilling Remarks _____

RECORD

Cased _____ in. _____ ft.

Sand _____

Gas _____

Oil _____

Total Depth _____

PRODUCTION

1st 24 hrs. Nat. _____

1st 24 hrs. after shot _____

Gas _____ cu. ft.

Dry Hole _____

Abandoned _____

Sedgwick


Map No. *KANSAS* Sec. *19* Twp. *27* R. *2E*
Well No. *10 Wheeler, Kelly, Hagney* Farm
Magnolia Pet. Company

 Ft. from N. Line

330 Ft. from S. Line

330 Ft. from E. Line

 Ft. from W. Line

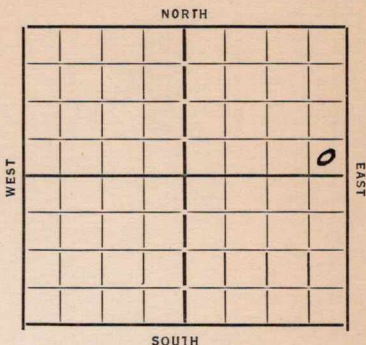

Date *1954*

REPORT

10/24 Celler
11/1 Rig
11/8 RVL
11/15 Spud
11/22 Dlg 1419 20" 42 13" 1191
11/28 " 1735 10" 1558
12/6 K.C. 2492 A.O. 2520-25
Dlg 2648
12/13 Chst 2940-8"
12/31 2950 TD Sub 125 Bbls
24 hrs.
12/26 Chst 2940 TD 2950
125 Bbls.

COMPLETED

KANSAS

Map No. 12 Sec. 19 Twp. 27 R. 28Well No. 10 - Wheeler, Kelly, HagneyMagnolia pet Company

Contractor

FIRST REPORT

SECTION PLAT

			0

Ft. from N. Line

330 Ft. from S. Line330 Ft. from E. Line

Ft. from W. Line

Location _____

Rig up _____

Drilling and Remarks:

clear

RECORD

Cased _____ in., _____ ft.

Sand _____

Gas _____

Oil _____

Total Depth _____

PRODUCTION

1st 24 hrs. Nat. _____

1st 24 hrs. after shot _____

Gas _____ Cu. Ft.

Dry Hole _____

Abandoned _____

Date

10-27-37 19

ORVAL MANNSCHRECK

Scout

Map No. 12 Sec. 19 Twp. 27 R. 2E

Well No. 10-Wheeler, Kelly Haggerty
Magnolia Company

Contractor

COMPLETED

SECTION PLAT

			0

Ft. from N. Line

330 Ft. from S. Line

330 Ft. from E. Line

Ft. from W. Line

RECORD

Location

Cased in. ft.

Rig up

Sand Chat 2940

Drilling and Remarks:

Gas

Oil

Total Depth 2950

PRODUCTION

1st 24 hrs. Nat.

1st 24 hrs. after shot

Gas Cu. Ft.

Dry Hole

Abandoned

125 bbls

Date

ORVAL MANNSCHRECK

12-26-34 192

Scout