

Map No. **KANSAS** Sec. 20 Twp. 27 R. 2^E

Well No. 1- Rimmel Farm

E. Jones et al Company


990 Ft. from N. Line

_____ Ft. from S. Line

_____ Ft. from E. Line

330
~~990~~ Ft. from W. Line

1930

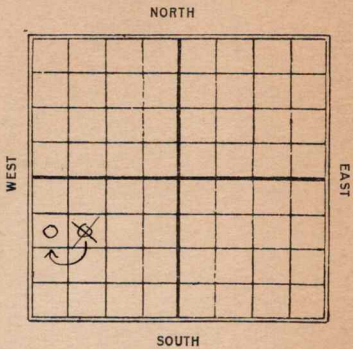

Date	REPORT
7/2	Lee
7/16	_____
7/23	Roll.
7/30	Bldg. rig
8/6	Rig
8/13	Rigged up & S.D.
8/20	Dyly 545'
8/27	" 1280'
9/3	" 1810'
9/10	" 2670'
9/17	Chat 2960-75 HFW
9/24	Dyly 2983
	5" - 3160
	Base miss lime 3213
	Sand 3266-77
	350' oil & 2500' water
10/1	Kilcor 3327 HFW
	T.D. 3400
	Dry & abandon

Map No. 12 **KANSAS** Sec. 20 Twp. 27 R. 2E

Well No. 1 Rincel

E. F. Jones & Dal Company

Contractor

SECTION PLAT

990 Ft. from N. Line

_____ Ft. from S. Line

_____ Ft. from E. Line

990 Ft. from W. Line

FIRST REPORTS

Location ✓

Rig up _____

Drilling and Remarks:

RECORD

Cased _____ in., _____ ft.

Sand _____

Gas _____

Oil _____

Total Depth _____

PRODUCTION

1st 24 hrs. Nat. _____

1st 24 hrs. after shot _____

Gas _____ Cu. Ft.

Dry Hole _____

Abandoned _____

Date

JUL 2 1930

19

S. J. LEWIS

Scout

Form 26-1M Dkt. 2-26
12

Map No. **KANSAS** Sec. 20 Twp. 27 R. 2E

Well No. 1 Rinal

E. F. Jones et al Company

Contractor

SECTION PLAT

990 Ft. from N. Line

_____ Ft. from S. Line

_____ Ft. from E. Line

330 Ft. from W. Line

CORRECTION

Location _____

Rig up _____

Drilling and Remarks:

*Reperated
8 Nov. 89*

RECORD

Cased _____ in., _____ ft.

Sand _____

Gas _____

Oil _____

Total Depth _____

PRODUCTION

1st 24 hrs. Nat. _____

1st 24 hrs. after shot _____

Gas _____ Cu. Ft.

Dry Hole _____

Abandoned _____

Date

SEP 10 1930
19

S. J. LEWIS

Scout

Map No. 12 **KANSAS** Sec. 20 Twp. 27 R. 2E

Well No. 1 Rime L

E. F. Jones & Dal Company

Contractor

SECTION PLAT

990 Ft. from N. Line

_____ Ft. from S. Line

_____ Ft. from E. Line

330 Ft. from W. Line

ABANDONED

Location _____

Rig up _____

Drilling and Remarks:

Wilson 3327
NFW

RECORD

Cased _____ in., _____ ft.

Sand _____

Gas _____

Oil _____

Total Depth 3400

PRODUCTION

1st 24 hrs. Nat. _____

1st 24 hrs. after shot _____

Gas _____ Cu. Ft.

Dry Hole _____

Abandoned _____

Date

OCT 1 1930

S. J. LEWIS Scout