


Section 20 Township 27 Range 2-E

Well No. #1 Mary Rimel

Company Magnolia

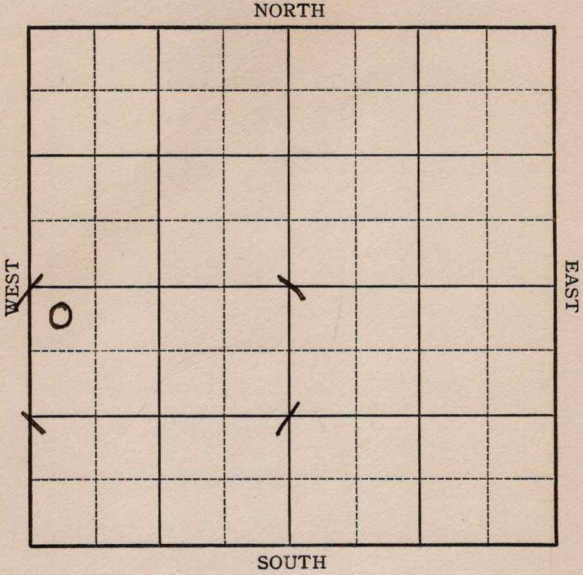

1937

10/27 6" @ 3225'.

Misner 3256'.

T.D. 3260'.

Pump 16 bbls. oil & 1 bbl.

water in 24 hrs.

1000 acid.

Pump 15 bbls. oil & 120 bbls.

water in 24 hrs.

ABANDONED

ABANDONED

KANSAS

Sedgwick

Map No. 12 Sec. 20 Twp. 27 R. 2^EWell No. 1-Mary RimelMagnolia Company

Contractor


FIRST REPORT

SECTION PLAT

330 Ft. from N. Line

_____ Ft. from S. Line

_____ Ft. from E. Line

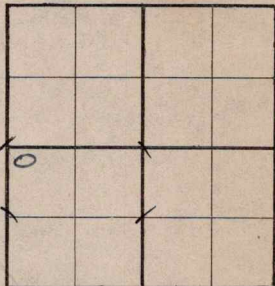330 Ft. from W. LineLocation ✓

Rig up _____

Drilling and Remarks:

RECORD

Cased _____ in., _____ ft.

Sand _____

Gas _____

Oil _____

Total Depth _____

PRODUCTION

1st 24 hrs. Nat. _____

1st 24 hrs. after shot _____

Gas _____ Cu. Ft.

Dry Hole _____

Abandoned _____

Date

AUG 11 1937 19H. D. Hatfield Scout

Sedgwick

KANSAS

Map No. 12 Sec. 20 Twp. 27 R. 2EWell No. 1 Mary RimelMagnolia

Company

Contractor

ABANDONED

NW SW

330 Ft. from N. Line Ft. from S. Line Ft. from E. Line330 Ft. from W. Line

SECTION PLAT

0			

Location Rig up

Drilling and Remarks:

P-16 bbls oil & 1 Bblwater - 24 hrs1000 AcidP-1.5 bbls oil& 120 bbls water24 hrsD & A

RECORD

Cased 6 in., 3225 ft.Sand Misner 3256Gas Oil Total Depth 3260

PRODUCTION

1st 24 hrs. Nat. 1st 24 hrs. after shot Gas Cu. Ft.Dry Hole Abandoned

Date

OCT 27 1937 19H. D. Hatfield

Scout