
Kingman KANSAS

SECTION 31 TOWNSHIP 29S RANGE 8W

WELL NO. #1 Dee

COMPANY Phillips Petrol.

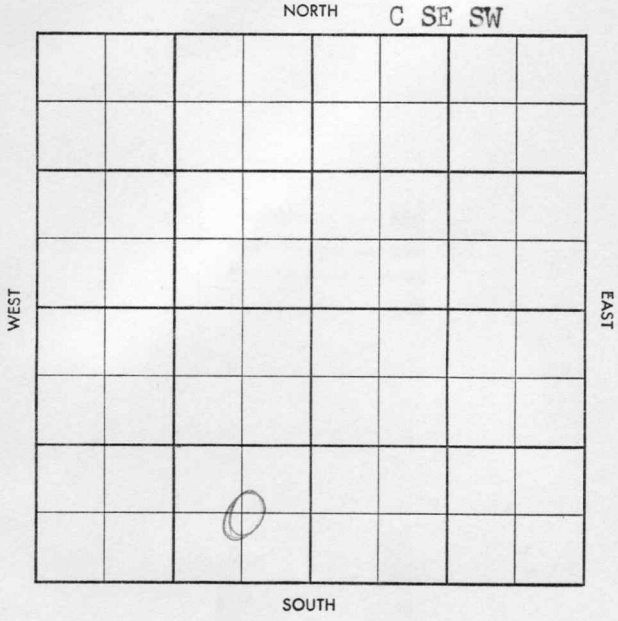

FORM 504-3 SUNRAY

Twp. X Pool X

Co. 1 Facet X

S-513-A

CO. Kingman ELEV. 1592 DF

SEC. 27 TWP. 29 RGE. 8W

COMPANY Phillips Petrol NO. 1

APR 23 '58 COMPLETE

FARM Dee

LOC. C SE SW

GEOL.

CONTR. Group Intl. Tools

POOL Spivey-Grabbs

SPUD 12/18/57

CH 323 w/275 sx.

2660. JAN 2 '58 3835

JAN 9 '58 Log Tops

4½ 4266/75

Log TOD 4326 4

TR 3280

TD 4270

Dg 3315 BL 3481 Lsg 3489 BKC 3958 Miss 4181 Li 4234 micT

JAN 15 '58 CO 4247 104/4201-27 3/1" ga 1.950 mcf/60"

CP 425 TP 140 ga 2.220 mcf/60" + 4g O + 19 g w

CP 400 TP 125 finc op Flo 2.790 mcf + Ld 32/64" chk CP 400 TP 250

SI 2½ hrs SITP 1275. SICP 1310 Flo 4.180 mcf CP 79 TP 340 3/4" chk

JAN 22 '58 ga 3.860 mcf 3/4" chk TP 320 CP 770 SD

JAN 25 '58 FEB 5 '58 ~~Op Flo 5.208 mcf~~ FEB 12 '58

SD w o pipeline FEB 19 '58

op Flo MAR 5 '58 MAR 12 '58 MAR 19 '58

MAR 20 '58 APR 2 '58 APR 9 '58 APR 16 '58 APR 23 '58

State tst Flo 5.973 mcf .15 BO pd SIP 1400 Miss 4201-27

CO. LSE. NO. SEC. TWP. RGE.

27

S-513-A

CO. Kingman ELEV.

SEC. 31 TWP. 29 RGE. 8W

COMPANY Phillips Petrol. NO. 1

FIRST REPORT

DEC 26 '57

o

FARM Dee

LOC. C SE SW

GEOL.

CONTR. Group Expl. tools

POOL

SPUD 12/18/57

8" @ 323 w/275, Drlg.

2660.

CO.

LSE.

NO.

SEC.

TWP.

RGE.